

LEGEND:

- AS-BUILT STORMWATER PIPE
- EXISTING STORMWATER PIPE
- REMOVED STORMWATER
- STORMWATER ABANDONED IN-SITU AND GROUT FILLED
- AS-BUILT STORMWATER MANHOLE
- EXISTING STORMWATER SOAKHOLE
- AS-BUILT STORMWATER CATCHPIT
- EXISTING STORMWATER CATCHPIT
- REMOVED STORMWATER CATCHPIT

THIS PLAN HAS BEEN PREPARED IN ACCORDANCE WITH AUCKLAND COUNCIL ENGINEERING APPROVAL ENG60356236

EACC AS BUILT PLAN CERTIFICATION

I CERTIFY THAT THESE AS-BUILT PLANS ARE AN ACCURATE RECORD OF THE WORKS UNDERTAKEN AND THAT:

- THE COORDINATES (X, Y) ARE IN TERMS OF NZTM ON NZGD(2000), AND ARE WITHIN +/- 50mm.
- THE LEVELS (Z) ARE IN TERMS OF THE AUCKLAND 1946 (MSL) LINZ DATUM (DOSLI DATUM), AND ARE WITHIN THE FOLLOWING TOLERANCES:
 - FOR ALL PIPE INVERTS & ROADSIDE CHANNELS TO BE WITHIN +/- 10mm (LOCAL CIRCUIT IE. INTERNAL/RELATIVE CONSISTENCY REQUIRED ONLY).
 - FOR ALL OTHER ASSETS +/-20mm (MANHOLE COVERS, EARTHWORKS).

SIGNED
LICENSED CAD SURVEYOR
NAME: RYAN BRUCE HEALEY DATE: 03.11.2023

Kāinga Ora
Homes and Communities

LEAD
ALLIANCE
Laying the Groundwork

2	FOR AS-BUILT	RBH	03.11.2023
1	FOR AS-BUILT	RBH	28.09.2023
REVISION DETAILS		BY	DATE

PROJECT:

ŌRANGA
BERM AND UTILITIES UPGRADE

DESCRIPTION:


STORMWATER FILTER (ED-1)
AS-BUILT PLAN

N


SURVEYED	LEAD	08.2023
DESIGNED	-	-
DRAWN	CA	08.2023
CHECKED	EG	03.11.2023
APPROVED	RBH	03.11.2023

SCALE	1:50 @A1	1:100 @A3	REVISION
STATUS	AS BUILT ISSUE		2
PRECINCT	ŌRANGA		
DWG NO	DIO041-AB50		


Plot Date: 9:24:48 am, 1 November 2023, COLE ATINUU

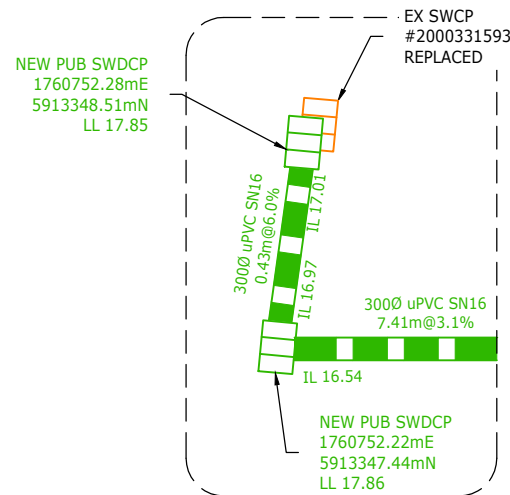


A NEW STORMWATER DETAIL
AB50 NOT TO SCALE

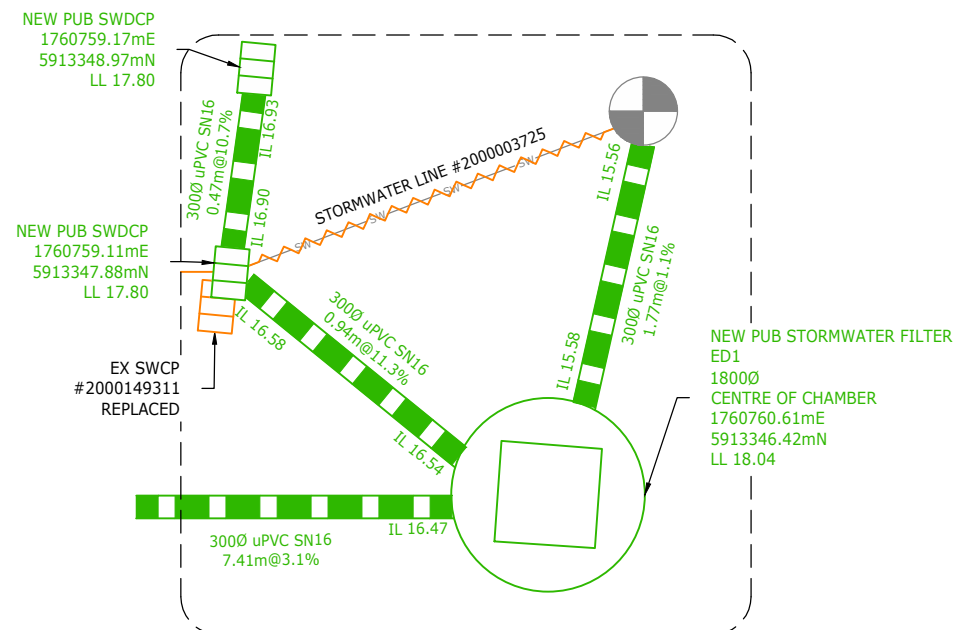

B NEW STORMWATER FILTER (ED-1) DETAIL
AB50 NOT TO SCALE

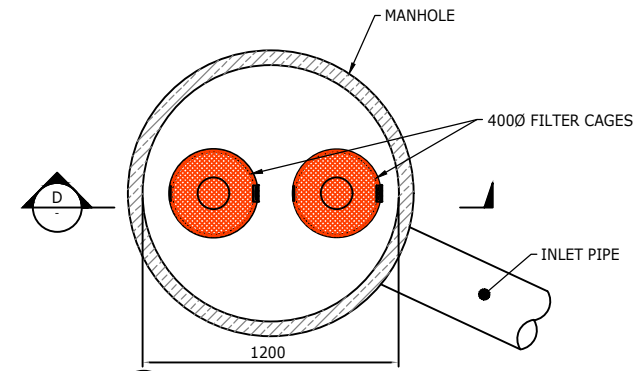

C #2001097307 SOAKHOLE WITH 2 BORES
NOT TO SCALE

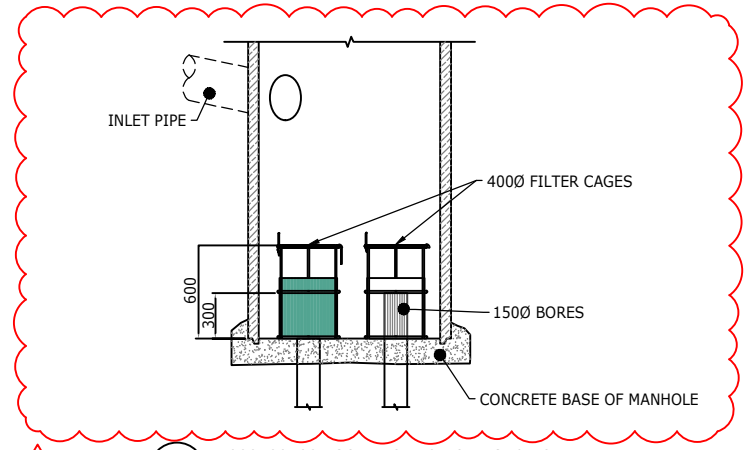

D #2001097307 SOAKHOLE 2 BORE SECTION DETAIL
NOT TO SCALE

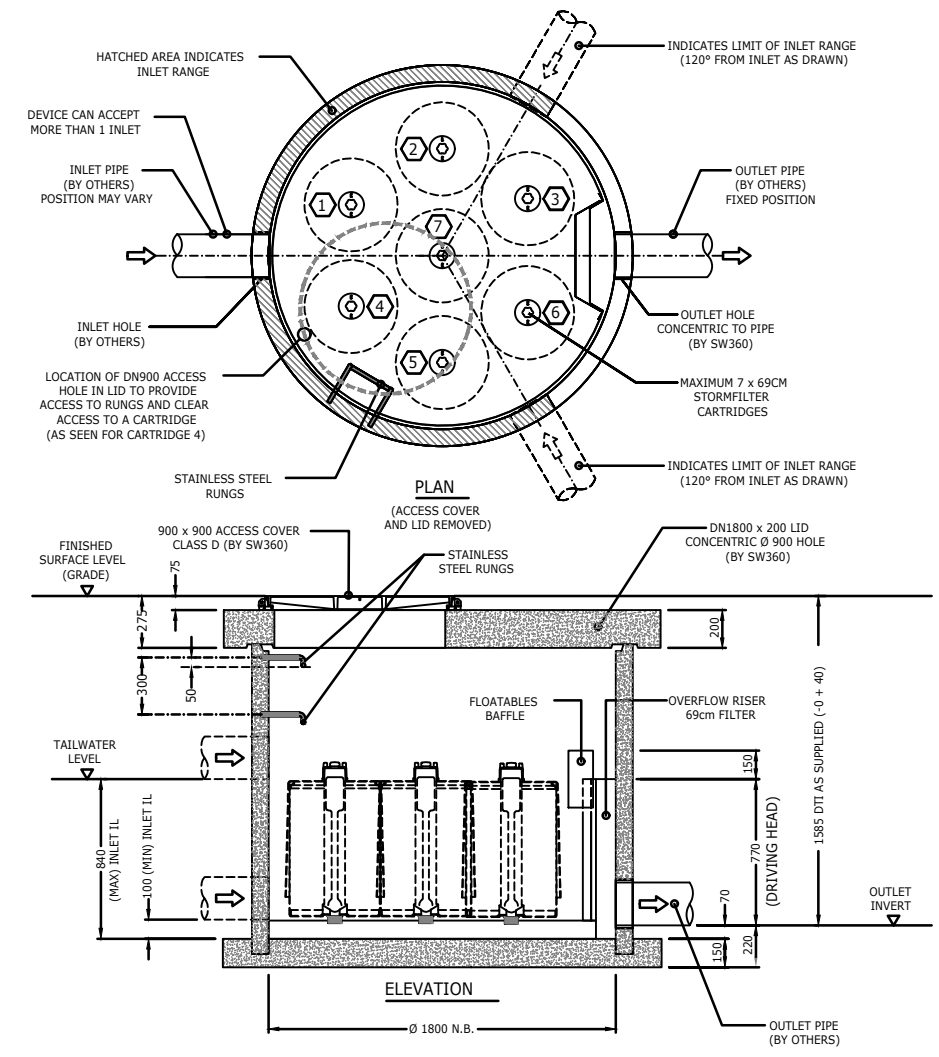


DIAGRAM - NOT TO SCALE

- LEGEND:**
- AS-BUILT STORMWATER PIPE
 - EXISTING STORMWATER PIPE
 - REMOVED STORMWATER
 - STORMWATER ABANDONED IN-SITU AND GROUT FILLED
 - AS-BUILT STORMWATER MANHOLE
 - EXISTING STORMWATER SOAKHOLE
 - AS-BUILT STORMWATER CATCHPIT
 - EXISTING STORMWATER CATCHPIT
 - REMOVED STORMWATER CATCHPIT

THIS PLAN HAS BEEN PREPARED IN ACCORDANCE WITH AUCKLAND COUNCIL ENGINEERING APPROVAL ENG60356236

EACC AS BUILT PLAN CERTIFICATION

I CERTIFY THAT THESE AS-BUILT PLANS ARE AN ACCURATE RECORD OF THE WORKS UNDERTAKEN AND THAT:

- THE COORDINATES (X, Y) ARE IN TERMS OF NZTM ON NZGD(2000), AND ARE WITHIN +/- 50mm.
- THE LEVELS (Z) ARE IN TERMS OF THE AUCKLAND 1946 (MSL) LINZ DATUM (DOSLI DATUM), AND ARE WITHIN THE FOLLOWING TOLERANCES:
 - FOR ALL PIPE INVERTS & ROADSIDE CHANNELS TO BE WITHIN +/- 10mm (LOCAL CIRCUIT IE. INTERNAL/RELATIVE CONSISTENCY REQUIRED ONLY).
 - FOR ALL OTHER ASSETS +/-20mm (MANHOLE COVERS, EARTHWORKS).

SIGNED
LICENSED CAD/CIVIL SURVEYOR
NAME: RYAN BRUCE HEALEY DATE: 03.11.2023



2	FOR AS-BUILT	RBH	03.11.2023
1	FOR AS-BUILT	RBH	28.09.2023
REVISION DETAILS		BY	DATE

PROJECT: ŌRANGA BERM AND UTILITIES UPGRADE

DESCRIPTION: STORMWATER FILTER (ED-1) AS-BUILT DETAILS

<div><div></div><div><div></div><div>N</div></div></div>	SURVEYED	LEAD	08.2023
	DESIGNED	-	-
	DRAWN	CA	08.2023
	CHECKED	EG	03.11.2023
	APPROVED	RBH	03.11.2023
SCALE	AS SHOWN		REVISION
STATUS	AS BUILT ISSUE		2
PRECINCT	ŌRANGA		
DWG NO	DIO041-AB50		