

NEW PUB SWCP
1760621.33mE
5913529.63mN
LL 25.52

STORMWATER #2000160204

NEW PUB SWCP
1760628.95mE
5913529.83mN
LL 25.41

EX RETROFITTED SW
SOAKHOLE #2001100242
1200Ø
1760631.13mE
5913530.05mN
LL 25.56

EX SWCP
#2000779656 REMOVED

225Ø uPVC SN16
8.41m @2.5%

NEW PUB SW FILTER ST-5
1200Ø
1760630.22mE
5913528.20mN
LL 25.62

IL 24.24

IL 24.03

STATE AVENUE

LEGEND:

- AS-BUILT STORMWATER PIPE
- EXISTING STORMWATER PIPE
- REMOVED STORMWATER
- STORMWATER ABANDONED IN-SITU AND GROUT FILLED
- AS-BUILT STORMWATER MANHOLE
- EXISTING STORMWATER SOAKHOLE
- EXISTING STORMWATER CATCHPIT
- REMOVED STORMWATER CATCHPIT

THIS PLAN HAS BEEN PREPARED IN ACCORDANCE WITH AUCKLAND COUNCIL ENGINEERING APPROVAL ENG60355983

EACC AS BUILT PLAN CERTIFICATION

I CERTIFY THAT THESE AS-BUILT PLANS ARE AN ACCURATE RECORD OF THE WORKS UNDERTAKEN AND THAT:

- THE COORDINATES (X, Y) ARE IN TERMS OF NZTM ON NZGD(2000), AND ARE WITHIN +/- 50mm.
- THE LEVELS (Z) ARE IN TERMS OF THE AUCKLAND 1946 (MSL) LINZ DATUM (DOSLI DATUM), AND ARE WITHIN THE FOLLOWING TOLERANCES:
 - FOR ALL PIPE INVERTS & ROADSIDE CHANNELS TO BE WITHIN +/- 10mm (LOCAL CIRCUIT IE. INTERNAL/RELATIVE CONSISTENCY REQUIRED ONLY).
 - FOR ALL OTHER ASSETS +/-20mm (MANHOLE COVERS, EARTHWORKS).

SIGNED
LICENSED CADASTRAL SURVEYOR

NAME: RYAN BRUCE HEALEY DATE: 03.11.2023



2	FOR AS-BUILT	RBH	03.11.2023
1	FOR AS-BUILT	RBH	20.09.2023
REVISION DETAILS		BY	DATE


PROJECT: **ŌRANGA BERM WORKS**

DESCRIPTION: **STORMWATER FILTER (ST-5) AS-BUILT PLAN**

N	SURVEYED	LEAD	08.2023
	DESIGNED	-	-
	DRAWN	CA	08.2023
	CHECKED	EG	03.11.2023
	APPROVED	RBH	03.11.2023

SCALE	1:20 @A1	1:40 @A3	REVISION
STATUS	AS BUILT ISSUE		2
PRECINCT	ŌRANGA		
DWG NO	DIO041-AB56		

0 0.4 1.0 2.0 SCALE (m) 1:20@A1 1:40@A3

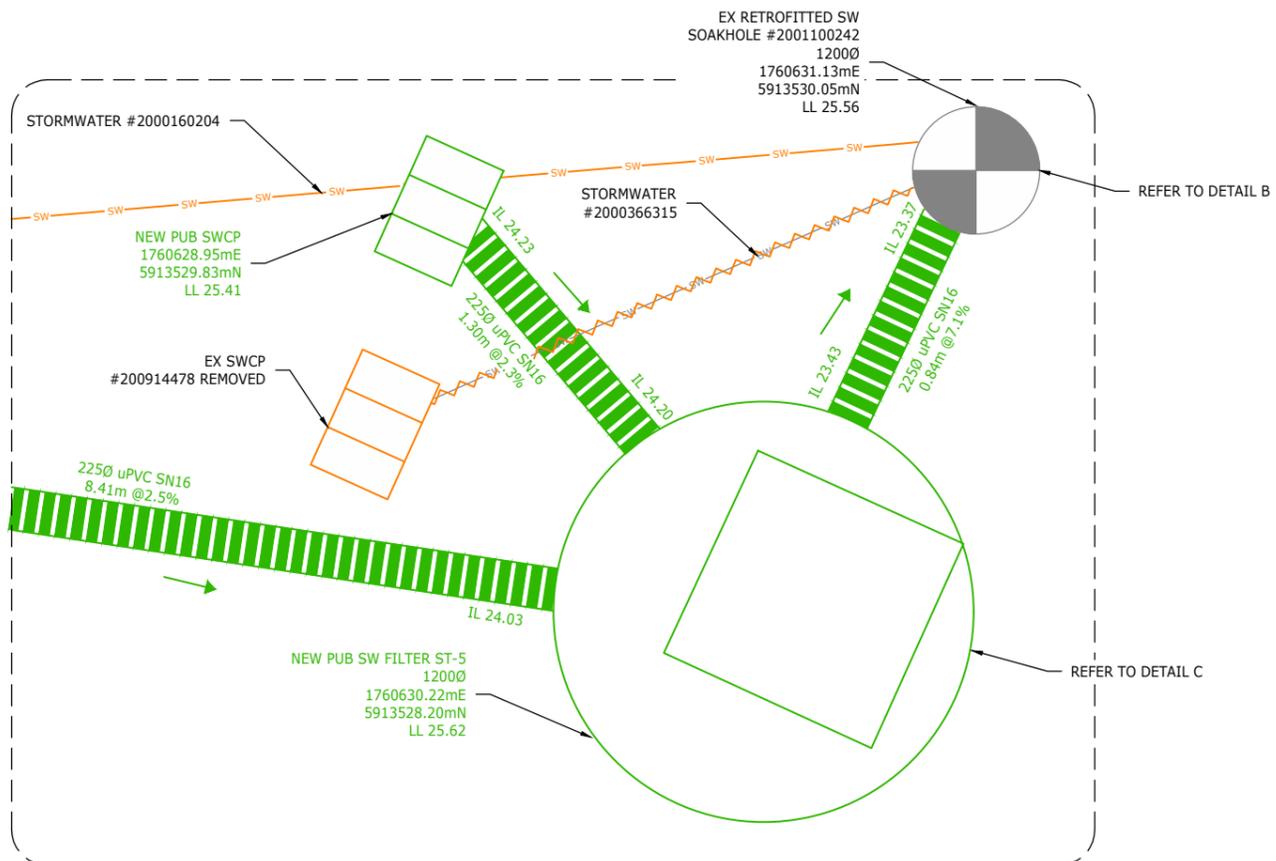

- LEGEND:**
- AS-BUILT STORMWATER PIPE
 - EXISTING STORMWATER PIPE
 - REMOVED STORMWATER
 - STORMWATER ABANDONED IN-SITU AND GROUT FILLED
 - AS-BUILT STORMWATER MANHOLE
 - EXISTING STORMWATER SOAKHOLE
 - EXISTING STORMWATER CATCHPIT
 - REMOVED STORMWATER CATCHPIT

THIS PLAN HAS BEEN PREPARED IN ACCORDANCE WITH AUCKLAND COUNCIL ENGINEERING APPROVAL ENG60355983

EACC AS BUILT PLAN CERTIFICATION

I CERTIFY THAT THESE AS-BUILT PLANS ARE AN ACCURATE RECORD OF THE WORKS UNDERTAKEN AND THAT:

- THE COORDINATES (X, Y) ARE IN TERMS OF NZTM ON NZGD(2000), AND ARE WITHIN +/- 50mm.
- THE LEVELS (Z) ARE IN TERMS OF THE AUCKLAND 1946 (MSL) LINZ DATUM (DOSLI DATUM), AND ARE WITHIN THE FOLLOWING TOLERANCES:
 - FOR ALL PIPE INVERTS & ROADSIDE CHANNELS TO BE WITHIN +/- 10mm (LOCAL CIRCUIT IE. INTERNAL/RELATIVE CONSISTENCY REQUIRED ONLY).
 - FOR ALL OTHER ASSETS +/-20mm (MANHOLE COVERS, EARTHWORKS).

SIGNED:

LICENSED CADASTRAL SURVEYOR

NAME: RYAN BRUCE HEALEY DATE: 03.11.2023



2	FOR AS-BUILT	RBH	03.11.2023
1	FOR AS-BUILT	RBH	20.09.2023
REVISION DETAILS		BY	DATE

PROJECT: **ŌRANGA BERM WORKS**

DESCRIPTION: **STORMWATER FILTER (ST-5) AS-BUILT DETAILS**

	SURVEYED	LEAD	08.2023
	DESIGNED	-	-
	DRAWN	CA	08.2023
	CHECKED	EG	03.11.2023
	APPROVED	RBH	03.11.2023
SCALE	AS SHOWN		REVISION
STATUS	AS BUILT ISSUE		2
PRECINCT	ŌRANGA		
DWG NO	DIO041-AB57		

