



LEGEND:

- NEW WATERMAIN LOT CONNECTION
- NEW WATERMAIN
- NEW WATERMAIN VESTED UNDER SEPERATE EPA
- EXISTING WATERMAIN
- ABANDONED WATERMAIN
- ABANDONED WATERMAIN UNDER SEPERATE EPA
- EXISTING WATER HYDRANT
- EXISTING SLUICE VALVE
- EXISTING PEET VALVE
- NEW SLUICE VALVE
- NEW WATER HYDRANT
- REMOVED SLUICE VALVE
- REMOVED HYDRANT
- REMOVED PEET VALVE
- SLUICE VALVE REMOVED UNDER SEPERATE EPA
- HYDRANT REMOVED UNDER SEPERATE EPA
- PEET VALVE REMOVED UNDER SEPERATE EPA
- NEW SLUICE VALVE VESTED UNDER SEPERATE EPA
- NEW WATER HYDRANT VESTED UNDER SEPERATE EPA
- PEET VALVE VESTED UNDER SEPERATE EPA
- ANCHOR BLOCK

NOTES:

1. ALL LOT CONNECTIONS ARE 25mm ID PE PIPES
- PE WATERMANS**
 THE WATERMANS BELOW ARE TO THE SPECIFICATION:
 MDPE PE80B SDR11 PN 12.5 COLOURED BLUE (AS/NZS 4130/4131)
- ID-50: DN63 - ACTUAL 63.30D/51.00ID
 - ID-100: DN125 - ACTUAL 125.0D/106.10ID
 - ID-150: DN180 - ACTUAL 180.0D/152.70ID
 - ID-200: DN250 - ACTUAL 250.0D/212.35ID
- THE WATERMANS BELOW ARE TO THE SPECIFICATION:
 MDPE PE100 SDR13.6 PN 12.5 COLOURED BLUE (AS/NZS 4130/4131)

THIS PLAN HAS BEEN PREPARED IN ACCORDANCE WITH AUCKLAND COUNCIL ENGINEERING APPROVAL ENG60352314

EACC AS BUILT PLAN CERTIFICATION

I CERTIFY THAT THESE AS-BUILT PLANS ARE AN ACCURATE RECORD OF THE WORKS UNDERTAKEN AND THAT:

- THE COORDINATES (X, Y) ARE IN TERMS OF NZTM ON NZGD(2000), AND ARE WITHIN +/- 50mm.
- THE LEVELS (Z) ARE IN TERMS OF THE AUCKLAND 1946 (MSL) LINZ DATUM (DOSLI DATUM), AND ARE WITHIN THE FOLLOWING TOLERANCES:
 - FOR ALL PIPE INVERTS & ROADSIDE CHANNELS TO BE WITHIN +/- 10mm (LOCAL CIRCUIT IE. INTERNAL/RELATIVE CONSISTENCY REQUIRED ONLY).
 - FOR ALL OTHER ASSETS +/-20mm (MANHOLE COVERS, EARTHWORKS).

SIGNED:
 LICENSED CASTRAL SURVEYOR
 NAME: RYAN BRUCE HEALEY DATE: 04.04.2024



3	FOR COA APPROVAL	RBH	04.04.2024
2	FOR COA APPROVAL	RBH	13.03.2024
1	COA APPROVAL	RBH	30.11.2023
REVISION DETAILS		BY	DATE


PROJECT: **ŌRANGA BERM AND UTILITIES UPGRADE**

DESCRIPTION: **STATE AVENUE WATERMAIN AS-BUILT OVERALL PLAN**

N	SURVEYED	LEAD	11.2023
	DESIGNED	-	-
	DRAWN	CEA	11.2023
	CHECKED	CA	04.04.2024
	APPROVED	RBH	04.04.2024

SCALE	1:250 @A1	1:500 @A3	REVISION
STATUS	AS BUILT ISSUE		3
PRECINCT	ŌRANGA		
DWG NO	DIO041-AB82		

0 5 12.5 25 SCALE (m) 1:250 @A1 1:500 @A3

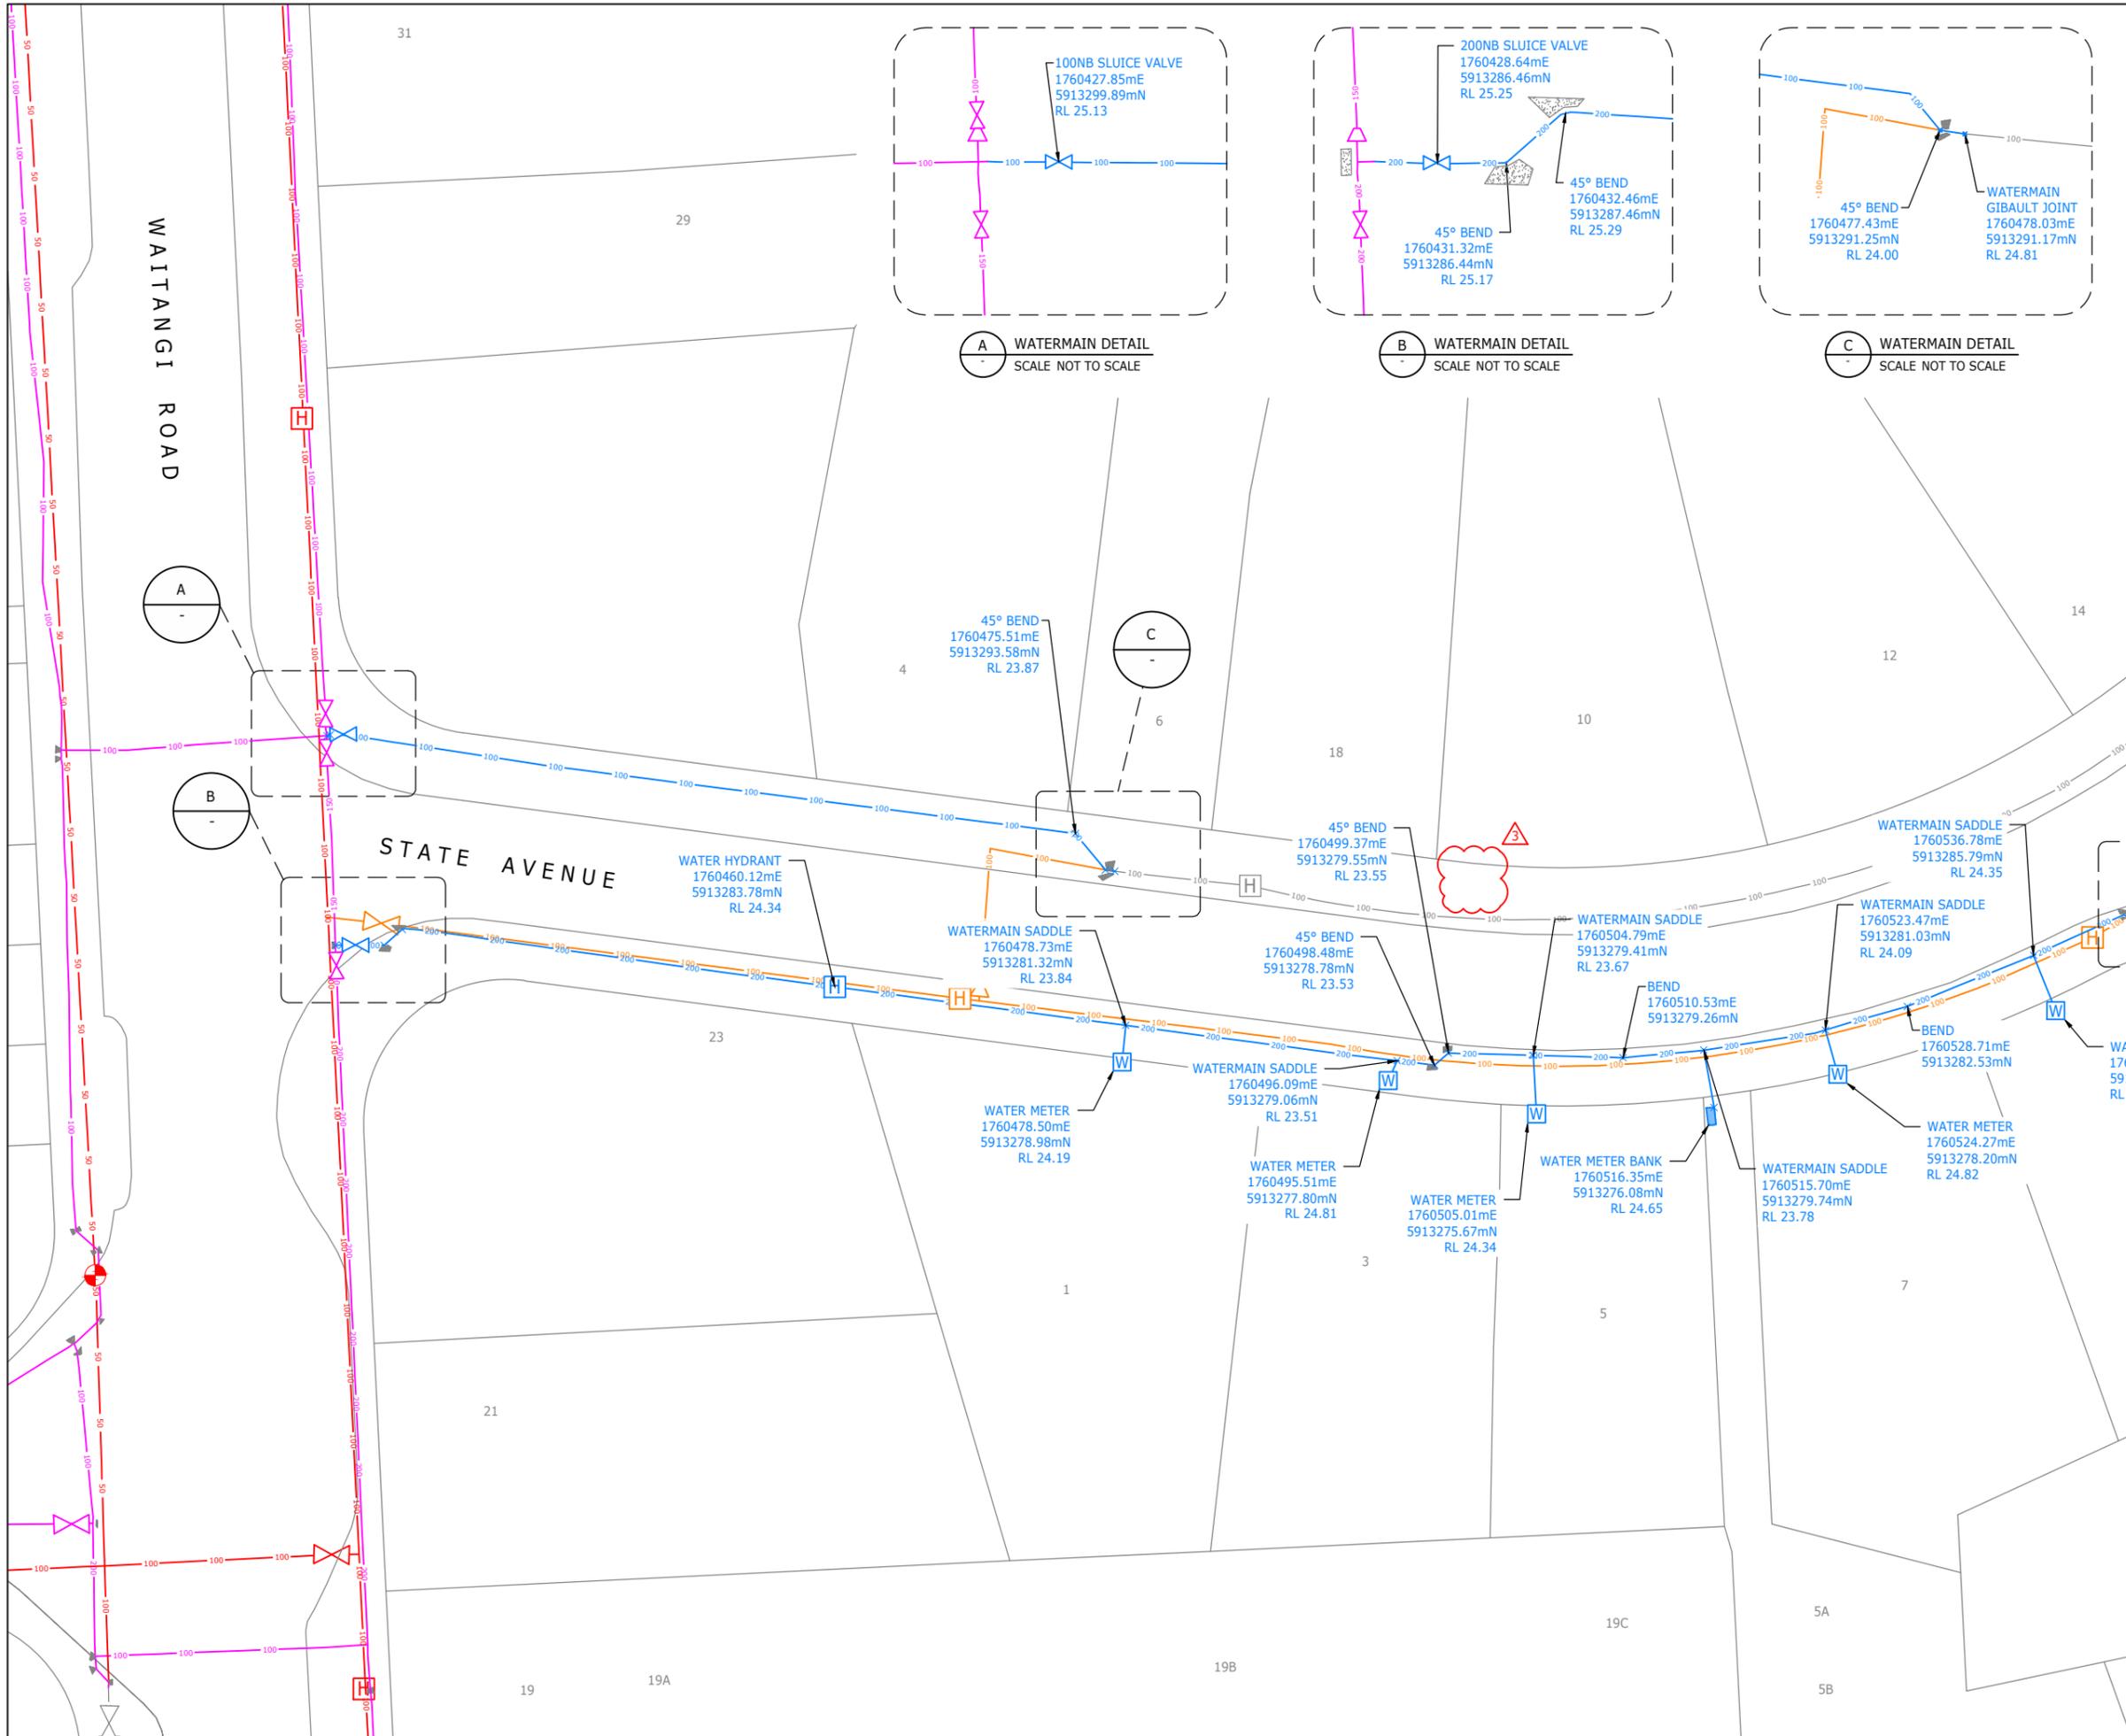

NOTE:
1. REFER TO DIO041-AB82 FOR NOTES AND LEGEND

THIS PLAN HAS BEEN PREPARED IN ACCORDANCE WITH AUCKLAND COUNCIL ENGINEERING APPROVAL ENG60352314

EACC AS BUILT PLAN CERTIFICATION
I CERTIFY THAT THESE AS-BUILT PLANS ARE AN ACCURATE RECORD OF THE WORKS UNDERTAKEN AND THAT:
• THE COORDINATES (X, Y) ARE IN TERMS OF NZTM ON NZGD(2000), AND ARE WITHIN +/- 50mm.
• THE LEVELS (Z) ARE IN TERMS OF THE AUCKLAND 1946 (MSL) LINZ DATUM (DOSLI DATUM), AND ARE WITHIN THE FOLLOWING TOLERANCES:
- FOR ALL PIPE INVERTS & ROADSIDE CHANNELS TO BE WITHIN +/- 10mm (LOCAL CIRCUIT IE. INTERNAL/RELATIVE CONSISTENCY REQUIRED ONLY).
- FOR ALL OTHER ASSETS +/-20mm (MANHOLE COVERS, EARTHWORKS).

SIGNED: *Ryan Bruce Healey*
LICENSED CATASTRAL SURVEYOR
NAME: RYAN BRUCE HEALEY DATE: 04.04.2024



REVISION	DESCRIPTION	BY	DATE
3	FOR COA APPROVAL	RBH	04.04.2024
2	FOR COA APPROVAL	RBH	13.03.2024
1	COA APPROVAL	RBH	30.11.2023


PROJECT: **ŌRANGA BERM AND UTILITIES UPGRADE**

DESCRIPTION: **STATE AVENUE WATERMAIN AS-BUILT PLAN SHEET 1**

STATUS	DESIGNED	DATE
SURVEYED	LEAD	11.2023
DESIGNED	-	-
DRAWN	CEA	11.2023
CHECKED	CA	04.04.2024
APPROVED	RBH	04.04.2024

SCALE	1:250 @A1	1:500 @A3	REVISION
SCALE	1:250 @A1	1:500 @A3	REVISION
STATUS	AS BUILT ISSUE		3
PRECINCT	ŌRANGA		
DWG NO	DIO041-AB83		

SCALE (m) 1:250 @A1
1:500 @A3

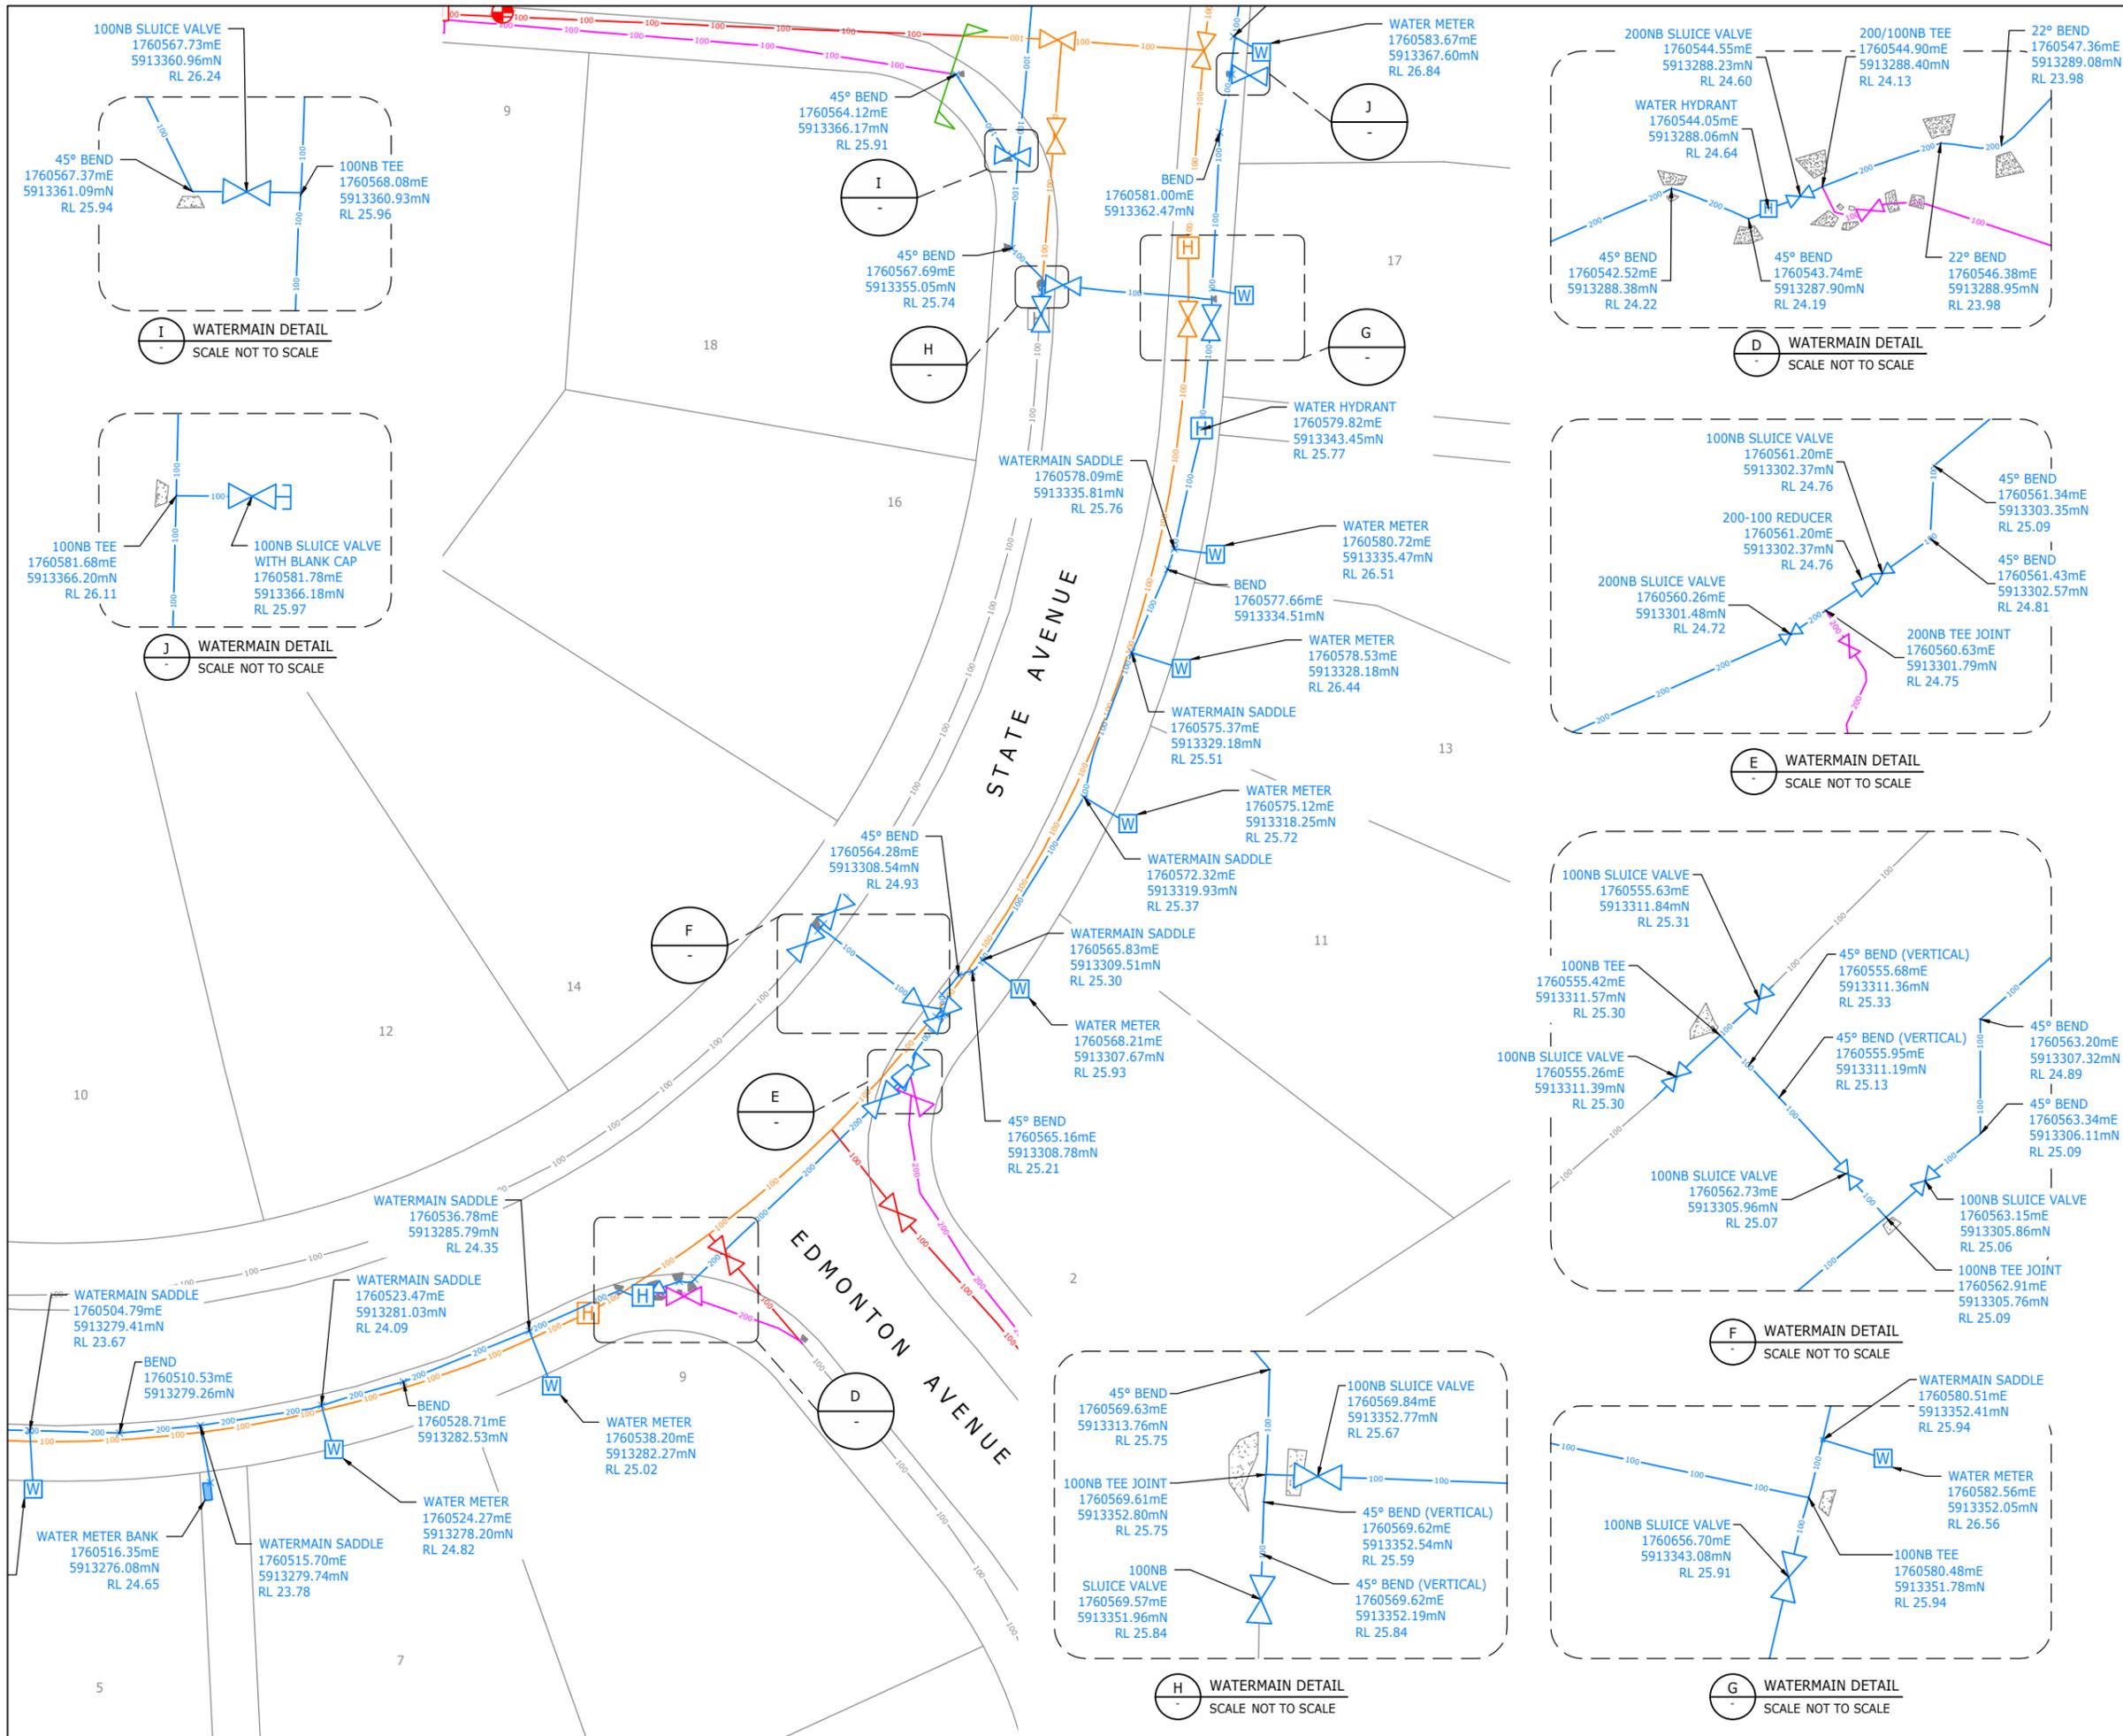

NOTE:
1. REFER TO D10041-AB82 FOR NOTES AND LEGEND

THIS PLAN HAS BEEN PREPARED IN ACCORDANCE WITH AUCKLAND COUNCIL ENGINEERING APPROVAL ENG60352314

EACC AS BUILT PLAN CERTIFICATION

I CERTIFY THAT THESE AS-BUILT PLANS ARE AN ACCURATE RECORD OF THE WORKS UNDERTAKEN AND THAT:

- THE COORDINATES (X, Y) ARE IN TERMS OF NZTM ON NZGD(2000), AND ARE WITHIN +/- 50mm.
- THE LEVELS (Z) ARE IN TERMS OF THE AUCKLAND 1946 (MSL) LINZ DATUM (DOSLI DATUM), AND ARE WITHIN THE FOLLOWING TOLERANCES:
 - FOR ALL PIPE INVERTS & ROADSIDE CHANNELS TO BE WITHIN +/- 10mm (LOCAL CIRCUIT IE. INTERNAL/RELATIVE CONSISTENCY REQUIRED ONLY).
 - FOR ALL OTHER ASSETS +/-20mm (MANHOLE COVERS, EARTHWORKS).

SIGNED: *Ryan Bruce Healey*
 LICENSED CADASTRAL SURVEYOR
 NAME: RYAN BRUCE HEALEY DATE: 04.04.2024



REVISION DETAILS	BY	DATE
3 FOR COA APPROVAL	RBH	04.04.2024
2 FOR COA APPROVAL	RBH	13.03.2024
1 COA APPROVAL	RBH	30.11.2023

PROJECT: **ŌRANGA BERM AND UTILITIES UPGRADE**

DESCRIPTION: **STATE AVENUE WATERMAIN AS-BUILT PLAN SHEET 2**

	SURVEYED	LEAD	11.2023
N	DESIGNED	-	-
	DRAWN	CEA	11.2023
	CHECKED	CA	04.04.2024
	APPROVED	RBH	04.04.2024
	SCALE	1:250 @A1	1:500 @A3

STATUS: **AS BUILT ISSUE**


PRECINCT: ŌRANGA

DWG NO: **D10041-AB84**

3



Plot Date: 7:25:05 am, 6 April 2024, COLE AINUU Synergy Version:

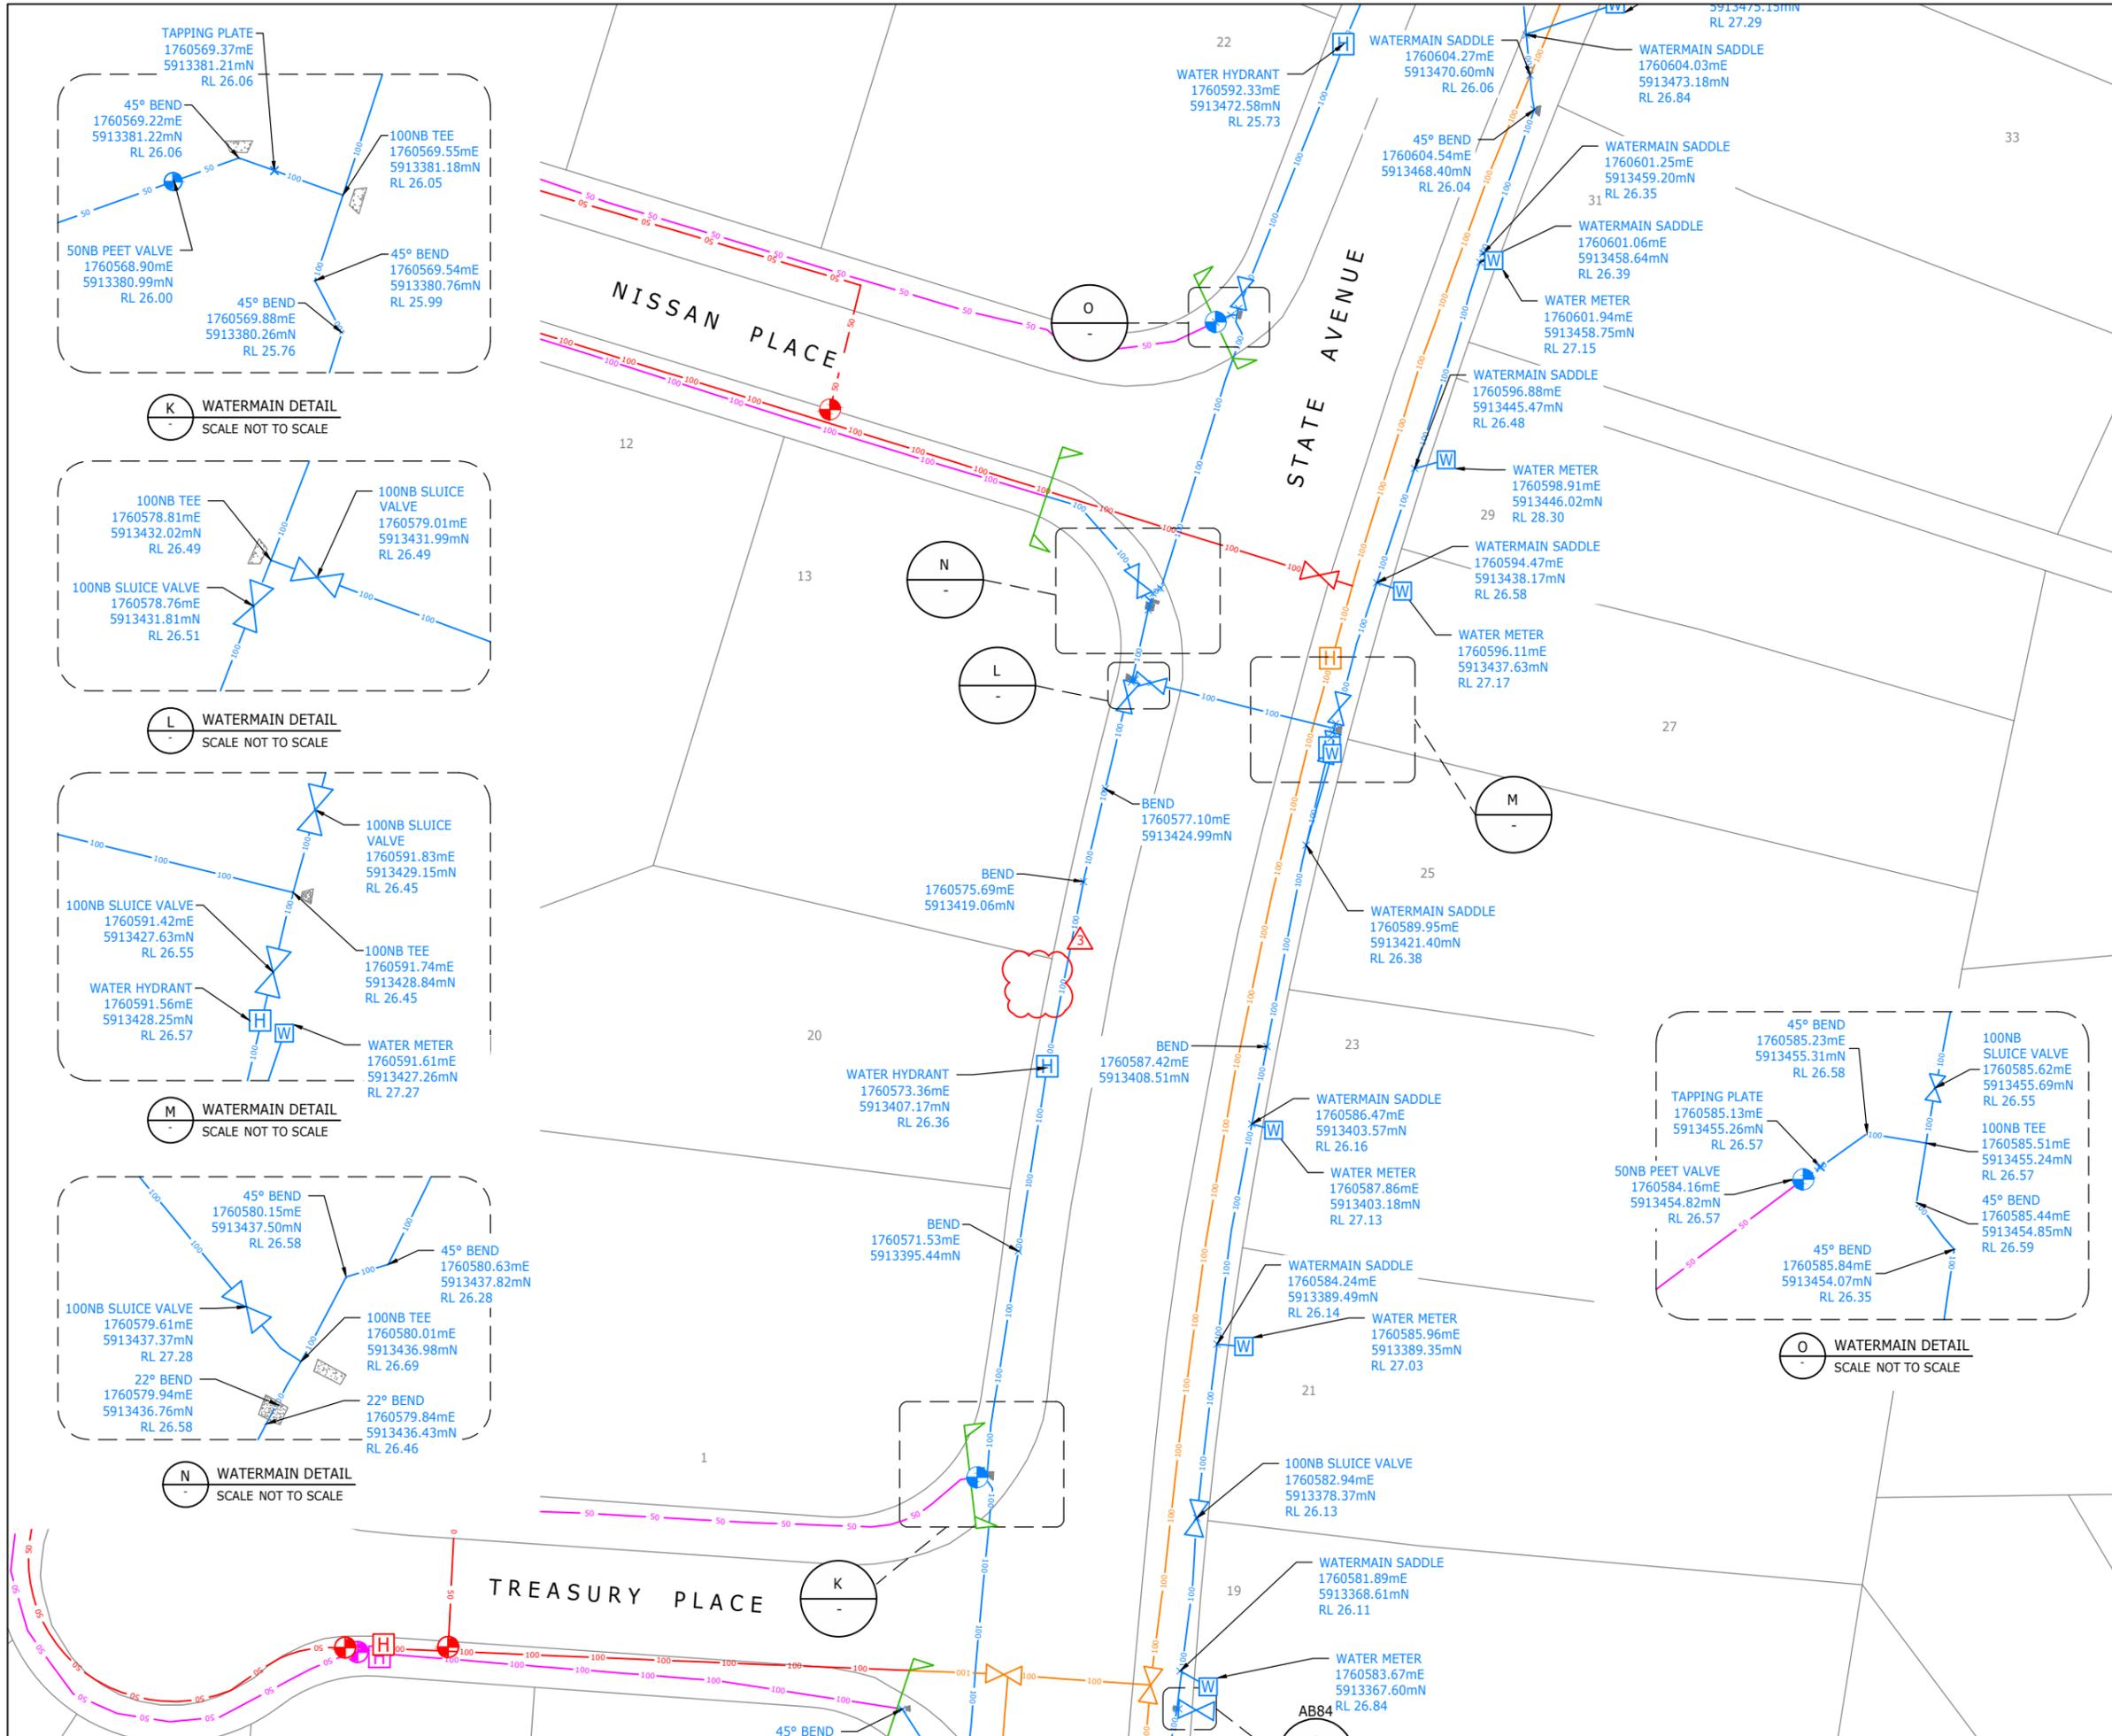

NOTE:
 1. REFER TO D10041-AB82 FOR NOTES AND LEGEND

THIS PLAN HAS BEEN PREPARED IN ACCORDANCE WITH AUCKLAND COUNCIL ENGINEERING APPROVAL ENG60352314

EACC AS BUILT PLAN CERTIFICATION

I CERTIFY THAT THESE AS-BUILT PLANS ARE AN ACCURATE RECORD OF THE WORKS UNDERTAKEN AND THAT:

- THE COORDINATES (X, Y) ARE IN TERMS OF NZTM ON NZGD(2000), AND ARE WITHIN +/- 50mm.
- THE LEVELS (Z) ARE IN TERMS OF THE AUCKLAND 1946 (MSL) LINZ DATUM (DOSLI DATUM), AND ARE WITHIN THE FOLLOWING TOLERANCES:
 - FOR ALL PIPE INVERTS & ROADSIDE CHANNELS TO BE WITHIN +/- 10mm (LOCAL CIRCUIT IE. INTERNAL/RELATIVE CONSISTENCY REQUIRED ONLY).
 - FOR ALL OTHER ASSETS +/-20mm (MANHOLE COVERS, EARTHWORKS).

SIGNED: *Ryan Bruce Healey*
 LICENSED CATASTRAL SURVEYOR
 NAME: RYAN BRUCE HEALEY DATE: 04.04.2024



NO	REVISION DETAILS	BY	DATE
3	FOR COA APPROVAL	RBH	04.04.2024
2	FOR COA APPROVAL	RBH	13.03.2024
1	COA APPROVAL	RBH	30.11.2023

PROJECT: **ŌRANGA BERM AND UTILITIES UPGRADE**



DESCRIPTION: **STATE AVENUE WATERMAIN AS-BUILT PLAN SHEET 3**

NO	REVISION	DATE
3	AS BUILT ISSUE	04.04.2024


PRECINCT: ŌRANGA

DWG NO: **D10041-AB85**


SCALE (m) 1:250 @A1
 1:500 @A3

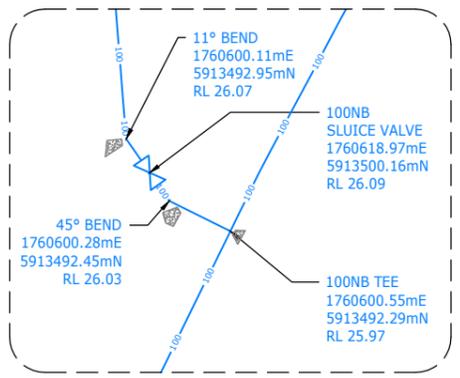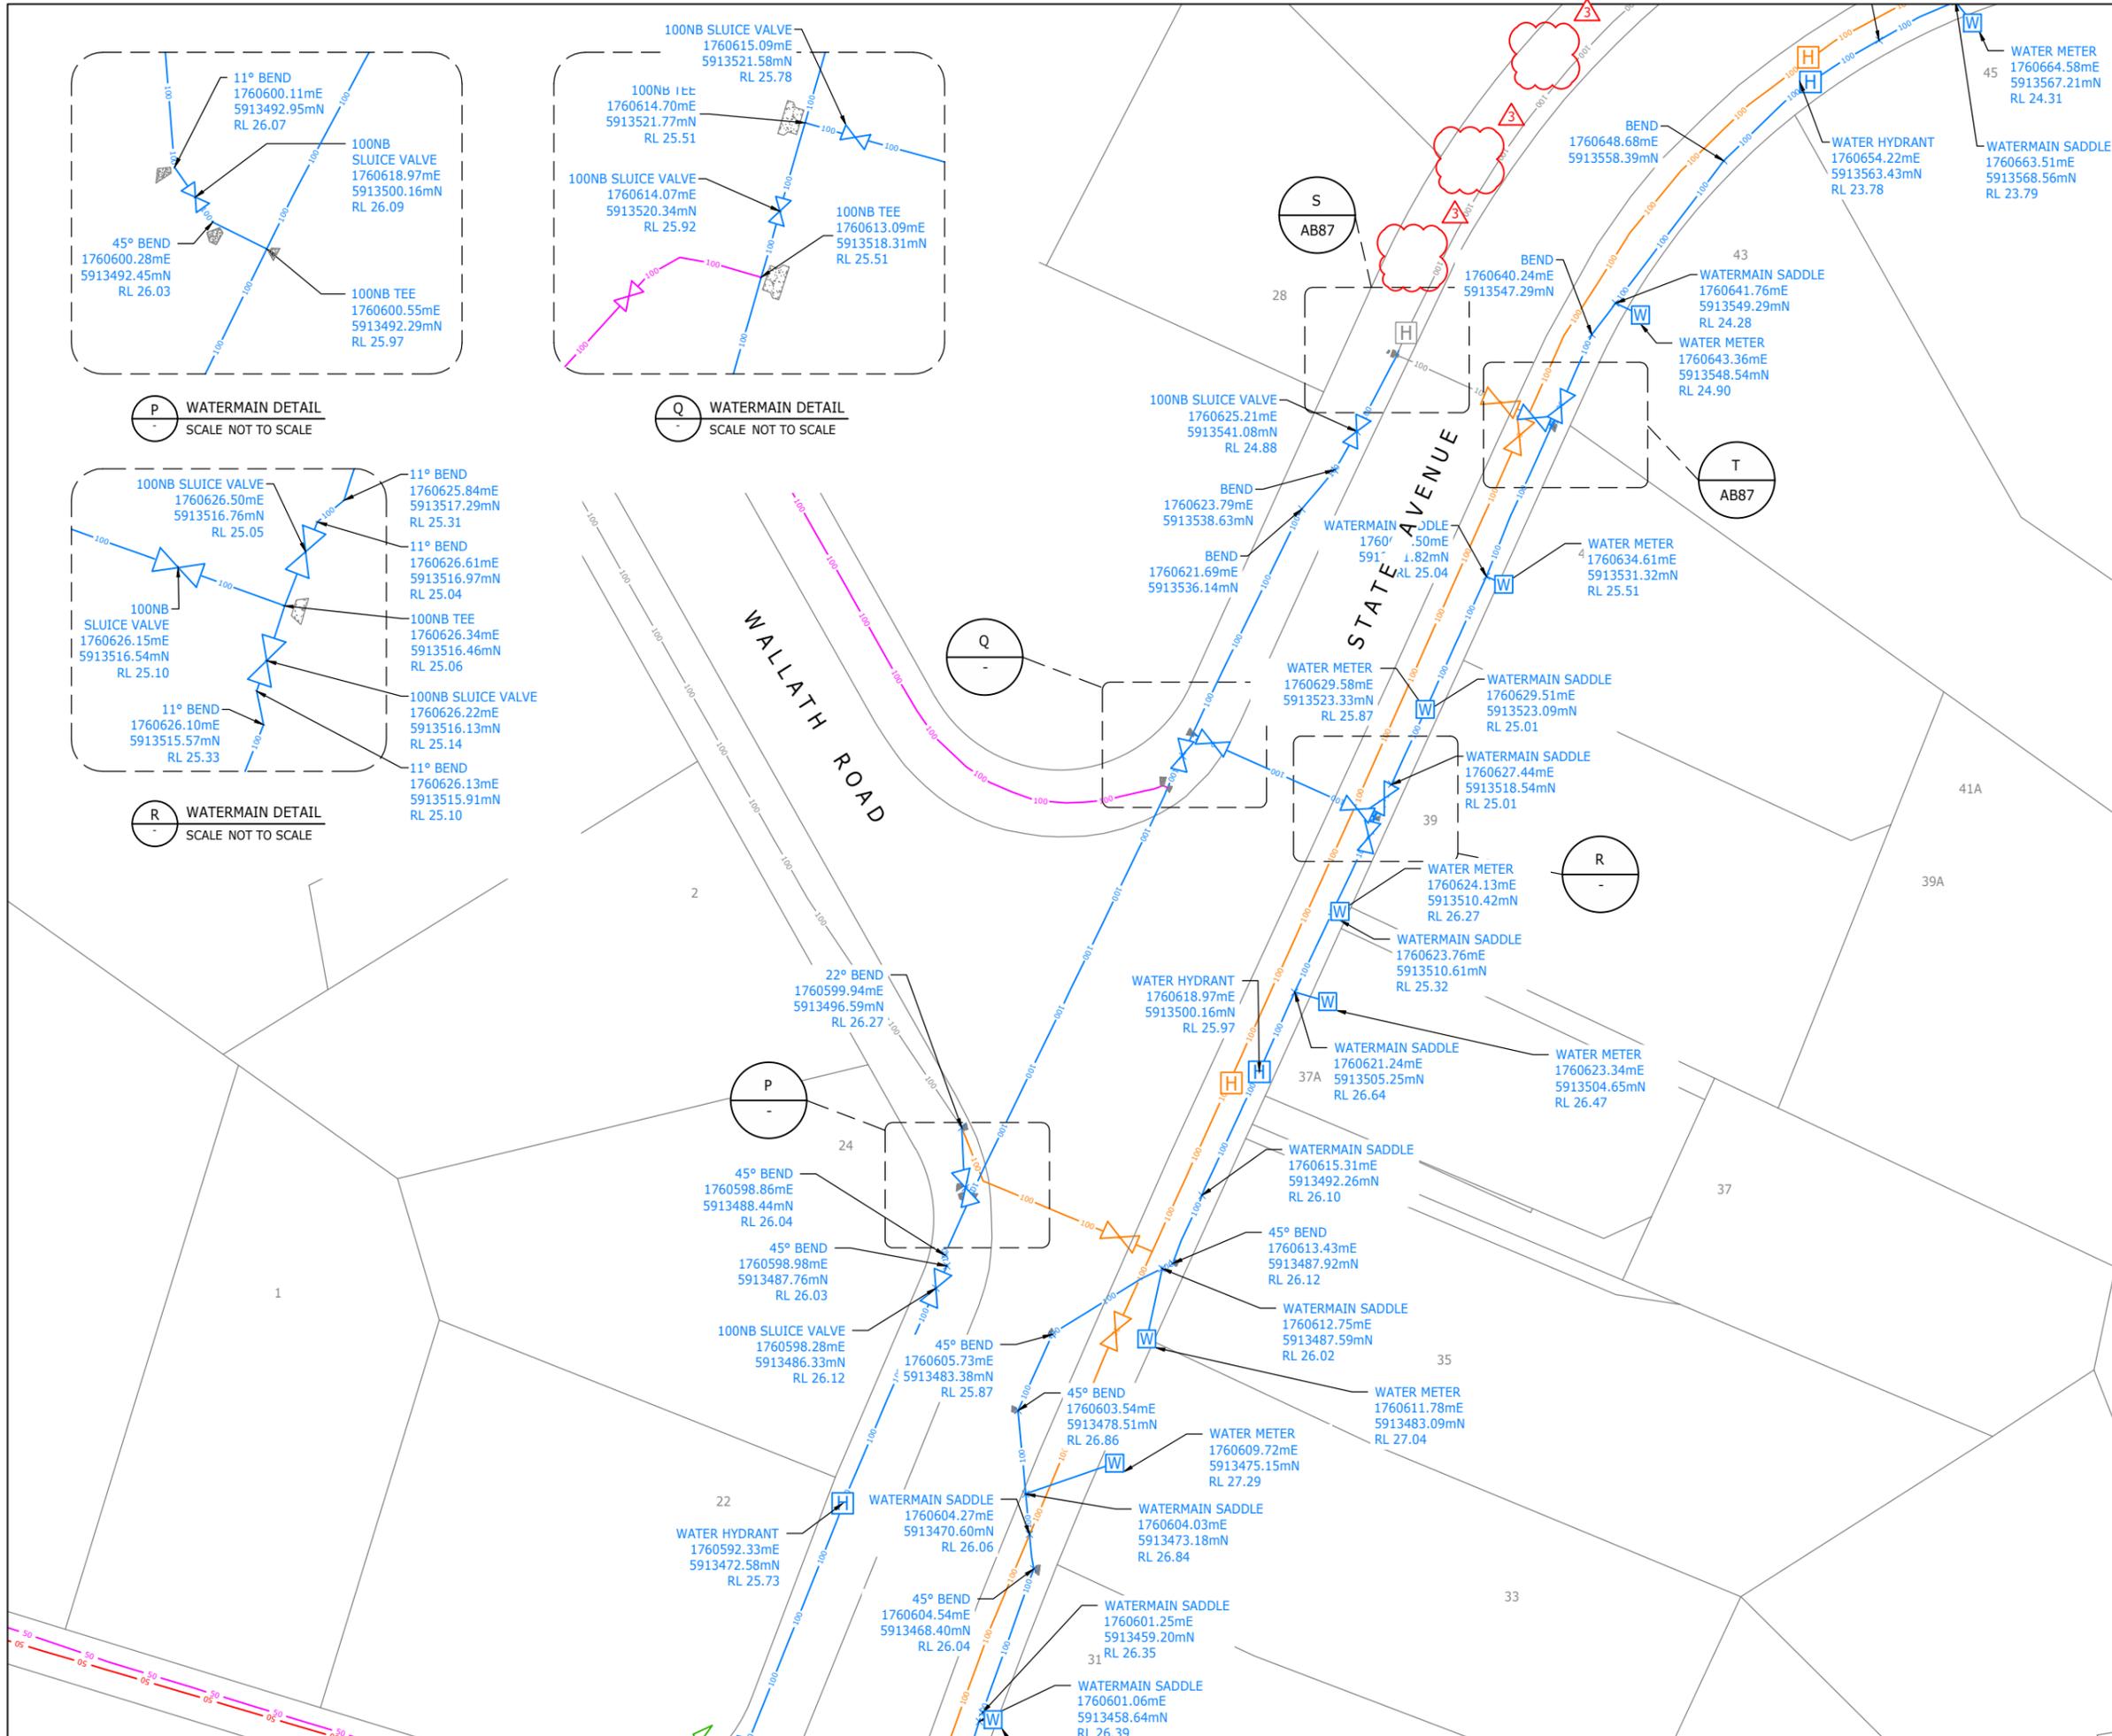

P WATERMAIN DETAIL
SCALE NOT TO SCALE

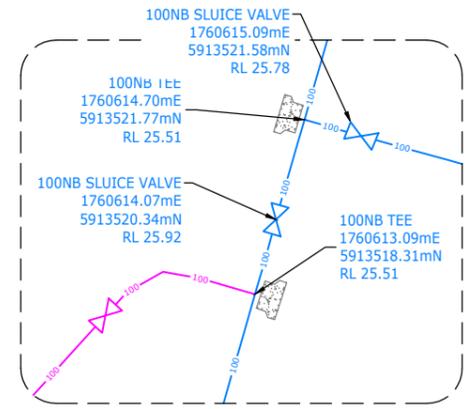

Q WATERMAIN DETAIL
SCALE NOT TO SCALE

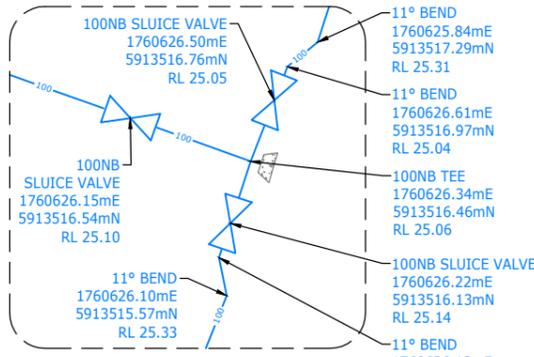

R WATERMAIN DETAIL
SCALE NOT TO SCALE

NOTE:
1. REFER TO D10041-AB82 FOR NOTES AND LEGEND

THIS PLAN HAS BEEN PREPARED IN ACCORDANCE WITH AUCKLAND COUNCIL ENGINEERING APPROVAL ENG60352314

EACC AS BUILT PLAN CERTIFICATION
I CERTIFY THAT THESE AS-BUILT PLANS ARE AN ACCURATE RECORD OF THE WORKS UNDERTAKEN AND THAT:
• THE COORDINATES (X, Y) ARE IN TERMS OF NZTM ON NZGD(2000), AND ARE WITHIN +/- 50mm.
• THE LEVELS (Z) ARE IN TERMS OF THE AUCKLAND 1946 (MSL) LINZ DATUM (DOSLI DATUM), AND ARE WITHIN THE FOLLOWING TOLERANCES:
- FOR ALL PIPE INVERTS & ROADSIDE CHANNELS TO BE WITHIN +/- 10mm (LOCAL CIRCUIT IE. INTERNAL/RELATIVE CONSISTENCY REQUIRED ONLY).
- FOR ALL OTHER ASSETS +/-20mm (MANHOLE COVERS, EARTHWORKS).

SIGNED: *Ryan Bruce Healey*
LICENSED CATASTRAL SURVEYOR
NAME: RYAN BRUCE HEALEY DATE: 04.04.2024



REVISION	DESCRIPTION	BY	DATE
3	FOR COA APPROVAL	RBH	04.04.2024
2	FOR COA APPROVAL	RBH	13.03.2024
1	COA APPROVAL	RBH	30.11.2023


PROJECT: **ŌRANGA BERM AND UTILITIES UPGRADE**

DESCRIPTION: **STATE AVENUE WATERMAIN AS-BUILT PLAN SHEET 4**

STATUS	SCALE	PRECINCT	DWG NO
AS BUILT ISSUE	1:250 @A1 1:500 @A3	ŌRANGA	D10041-AB86

0 5 12.5 25 SCALE (m) 1:250 @A1 1:500 @A3

Plot Date: 7:25:07 am, 6 April 2024, COLE AINUU Synergy Version:

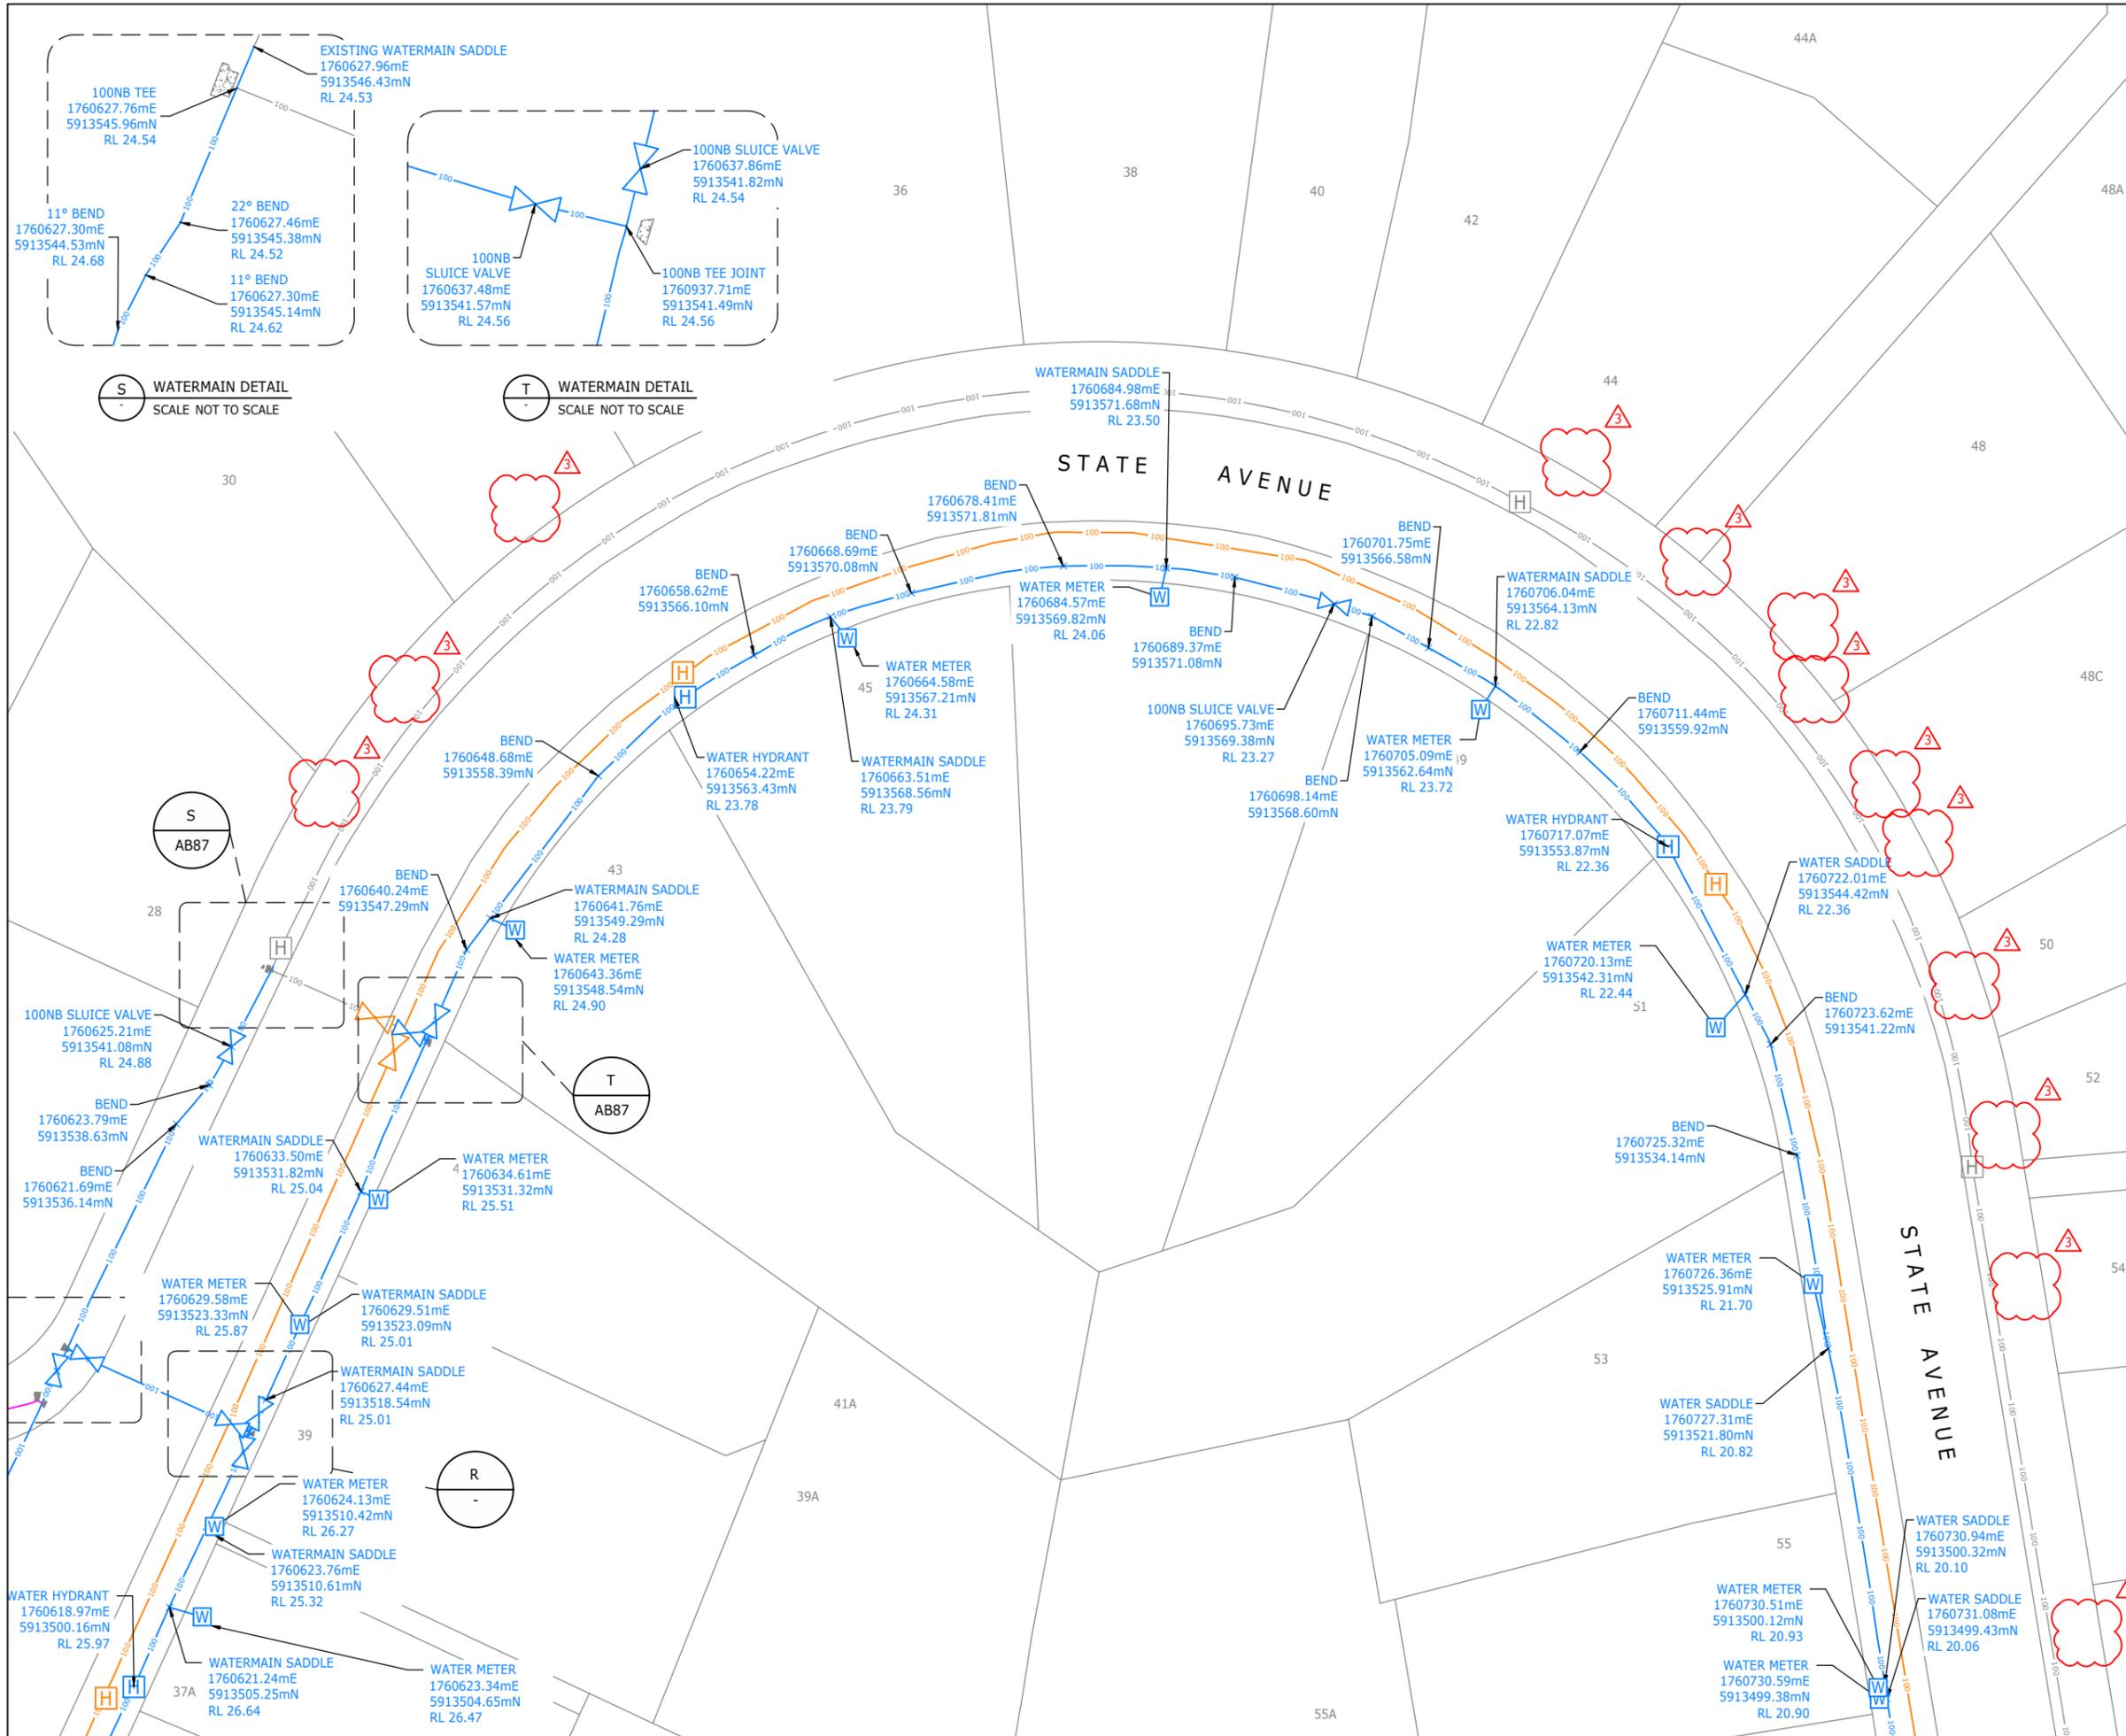

NOTE:
1. REFER TO D10041-AB82 FOR NOTES AND LEGEND

THIS PLAN HAS BEEN PREPARED IN ACCORDANCE WITH AUCKLAND COUNCIL ENGINEERING APPROVAL ENG60352314

EACC AS BUILT PLAN CERTIFICATION
I CERTIFY THAT THESE AS-BUILT PLANS ARE AN ACCURATE RECORD OF THE WORKS UNDERTAKEN AND THAT:
• THE COORDINATES (X, Y) ARE IN TERMS OF NZTM ON NZGD(2000), AND ARE WITHIN +/- 50mm.
• THE LEVELS (Z) ARE IN TERMS OF THE AUCKLAND 1946 (MSL) LINZ DATUM (DOSLI DATUM), AND ARE WITHIN THE FOLLOWING TOLERANCES:
- FOR ALL PIPE INVERTS & ROADSIDE CHANNELS TO BE WITHIN +/- 10mm (LOCAL CIRCUIT IE. INTERNAL/RELATIVE CONSISTENCY REQUIRED ONLY).
- FOR ALL OTHER ASSETS +/-20mm (MANHOLE COVERS, EARTHWORKS).

SIGNED: *Ryan Bruce Healey*
LICENSED CADASTRAL SURVEYOR
NAME: RYAN BRUCE HEALEY DATE: 04.04.2024



REVISION DETAILS	BY	DATE
3 FOR COA APPROVAL	RBH	04.04.2024
2 FOR COA APPROVAL	RBH	13.03.2024
1 COA APPROVAL	RBH	30.11.2023

PROJECT: **ŌRANGA BERM AND UTILITIES UPGRADE**

DESCRIPTION: **STATE AVENUE WATERMAIN AS-BUILT PLAN SHEET 5**


	SURVEYED	LEAD	11.2023
DESIGNED	-	-	-
DRAWN	CEA		11.2023
CHECKED	CA		04.04.2024
APPROVED	RBH		04.04.2024

SCALE: 1:250 @A1 | 1:500 @A3
STATUS: **AS BUILT ISSUE**
PRECINCT: ŌRANGA

DWG NO: **D10041-AB87**

0 5 12.5 25 SCALE (m) 1:250 @A1 1:500 @A3

Synergy Version: Plot Date: 7:25:07 am, 6 April 2024, COLE AINUU

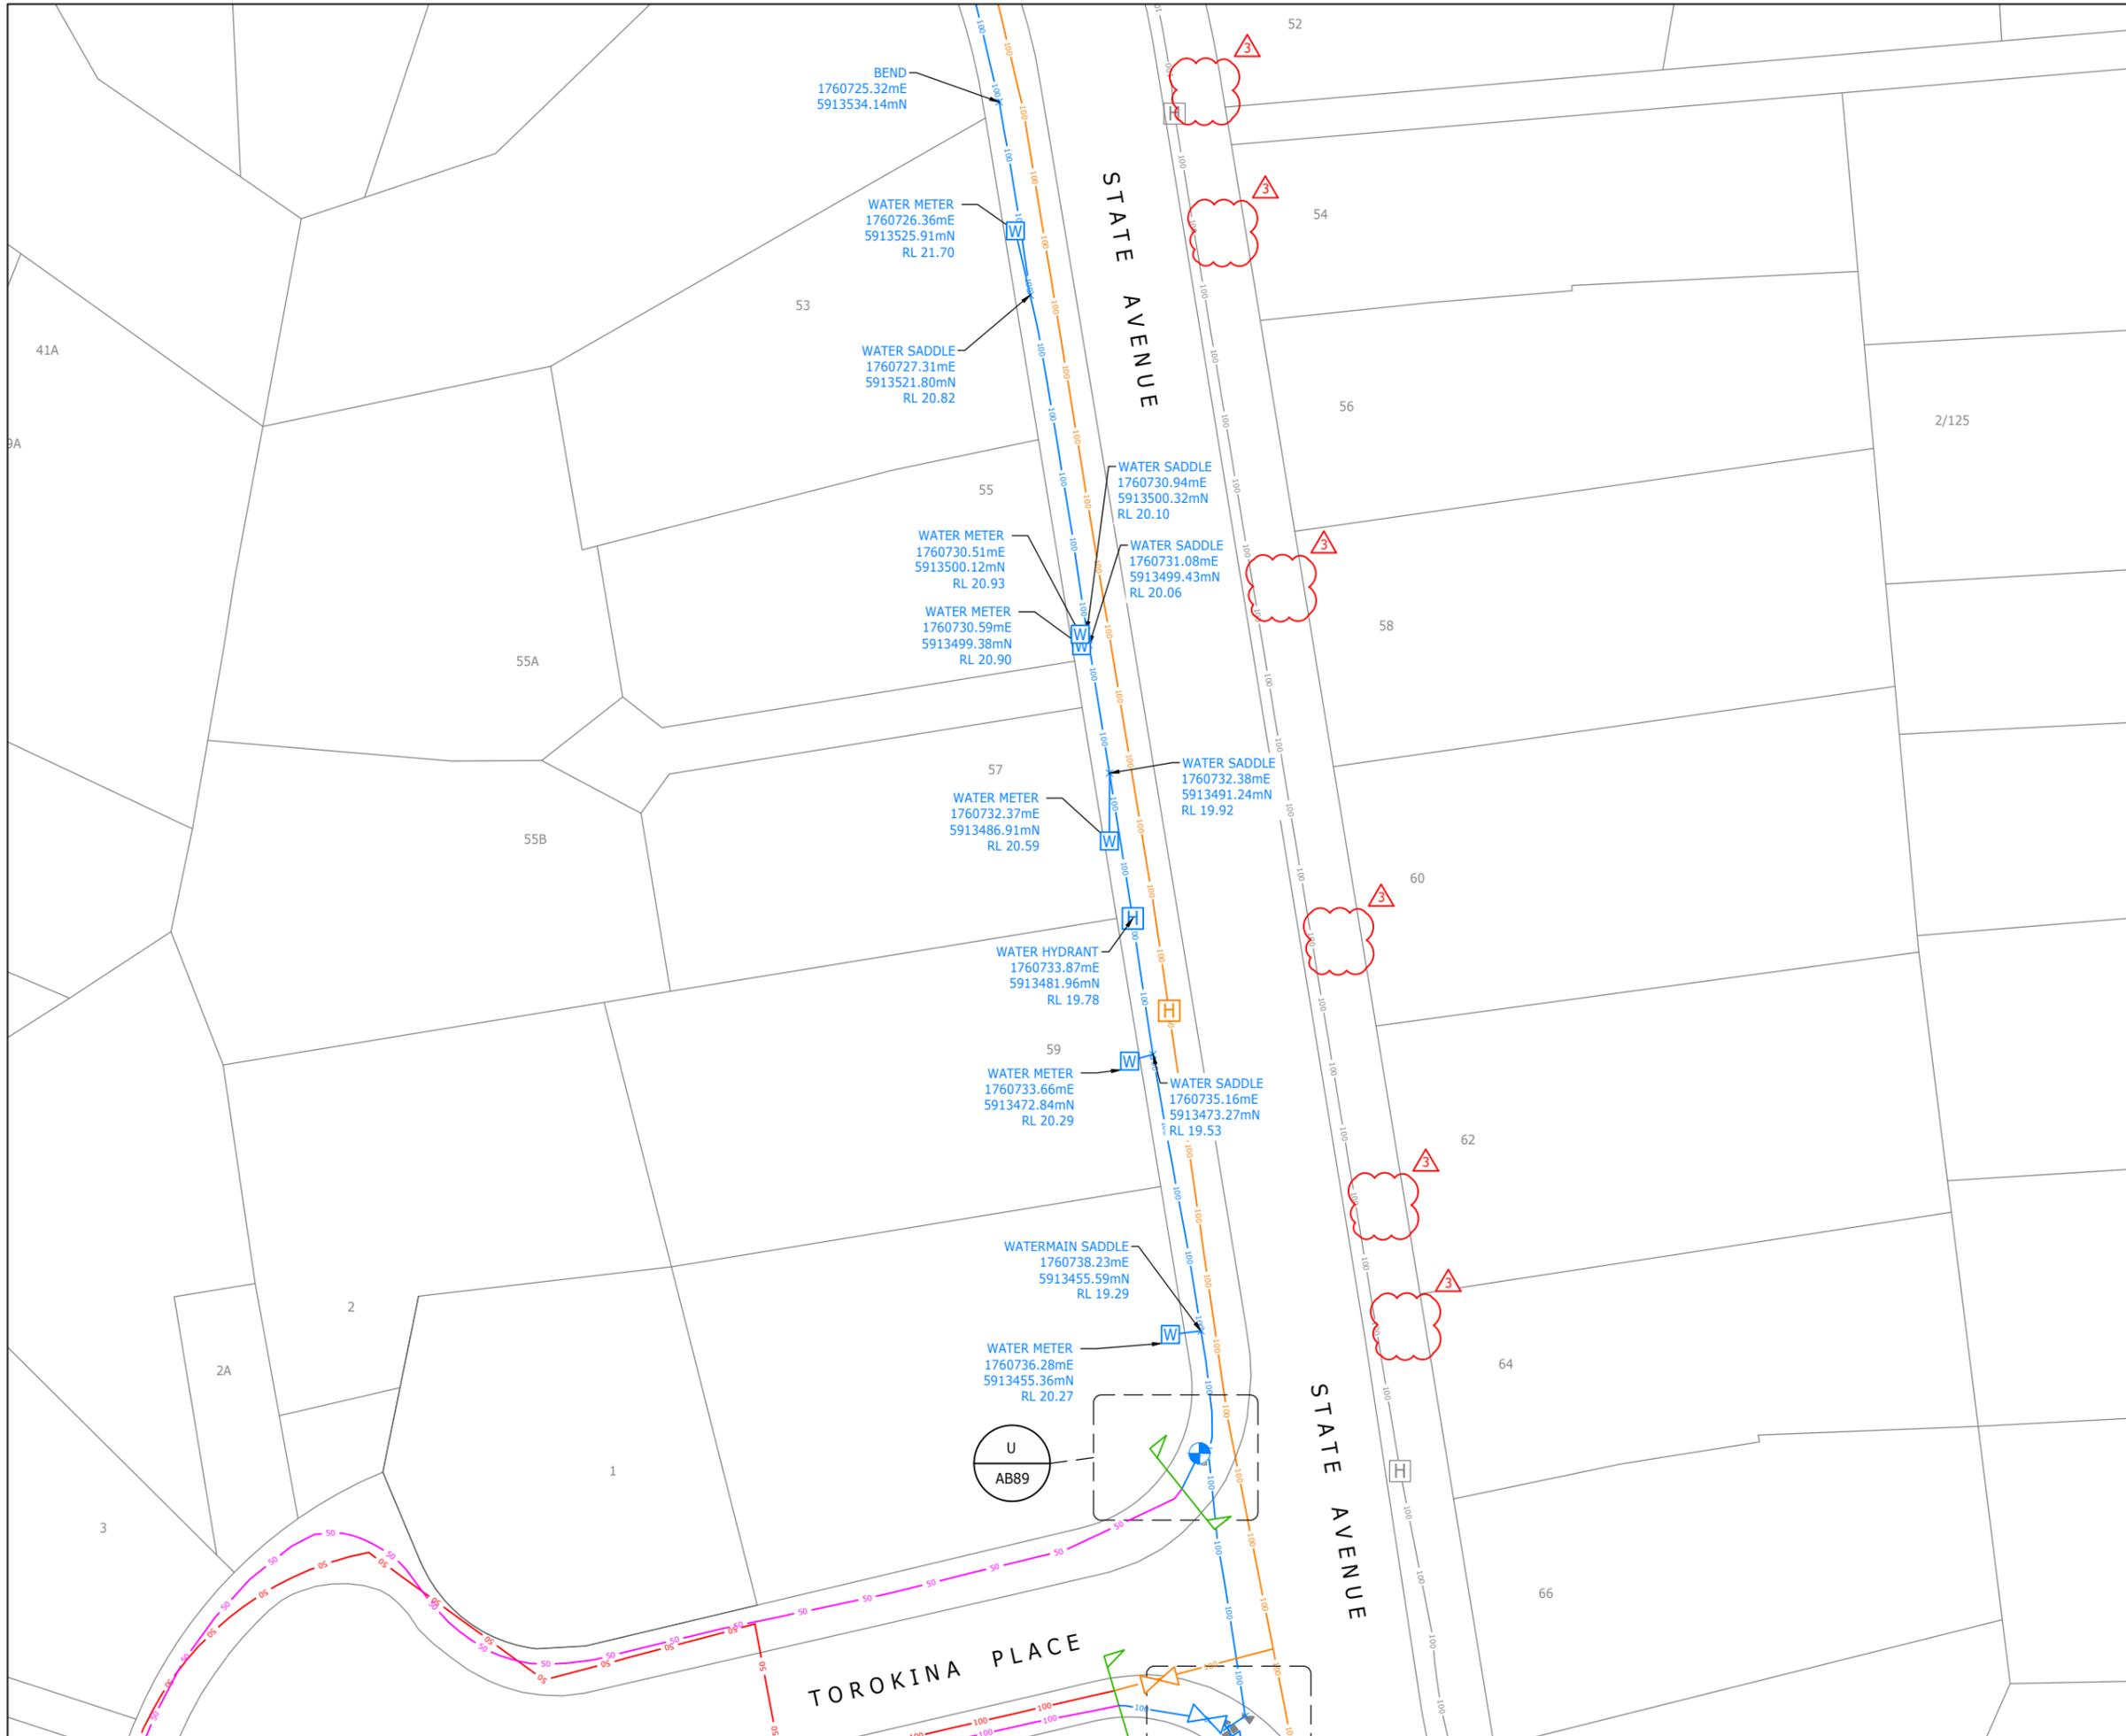

NOTE:
1. REFER TO D10041-AB82 FOR NOTES AND LEGEND

THIS PLAN HAS BEEN PREPARED IN ACCORDANCE WITH AUCKLAND COUNCIL ENGINEERING APPROVAL ENG60352314

EACC AS BUILT PLAN CERTIFICATION

I CERTIFY THAT THESE AS-BUILT PLANS ARE AN ACCURATE RECORD OF THE WORKS UNDERTAKEN AND THAT:

- THE COORDINATES (X, Y) ARE IN TERMS OF NZTM ON NZGD(2000), AND ARE WITHIN +/- 50mm.
- THE LEVELS (Z) ARE IN TERMS OF THE AUCKLAND 1946 (MSL) LINZ DATUM (DOSLI DATUM), AND ARE WITHIN THE FOLLOWING TOLERANCES:
 - FOR ALL PIPE INVERTS & ROADSIDE CHANNELS TO BE WITHIN +/- 10mm (LOCAL CIRCUIT IE. INTERNAL/RELATIVE CONSISTENCY REQUIRED ONLY).
 - FOR ALL OTHER ASSETS +/-20mm (MANHOLE COVERS, EARTHWORKS).

SIGNED: *Ryan Bruce Healey*
 LICENSED CADASTRAL SURVEYOR
 NAME: RYAN BRUCE HEALEY DATE: 04.04.2024



REVISION DETAILS	BY	DATE
3 FOR COA APPROVAL	RBH	04.04.2024
2 FOR COA APPROVAL	RBH	13.03.2024
1 COA APPROVAL	RBH	30.11.2023

PROJECT: **ŌRANGA BERM AND UTILITIES UPGRADE**


DESCRIPTION: **STATE AVENUE WATERMAIN AS-BUILT PLAN SHEET 6**

	SURVEYED	LEAD	11.2023
N	DESIGNED	-	-
	DRAWN	CEA	11.2023
	CHECKED	CA	04.04.2024
	APPROVED	RBH	04.04.2024
	SCALE	1:250 @A1	1:500 @A3

STATUS	AS BUILT ISSUE	3
PRECINCT	ŌRANGA	
DWG NO	DIO041-AB88	

0 5 12.5 25 SCALE (m) 1:250 @A1 1:500 @A3

Plot Date: 7:25:08 am, 6 April 2024, COLE AINUU Synergy Version:

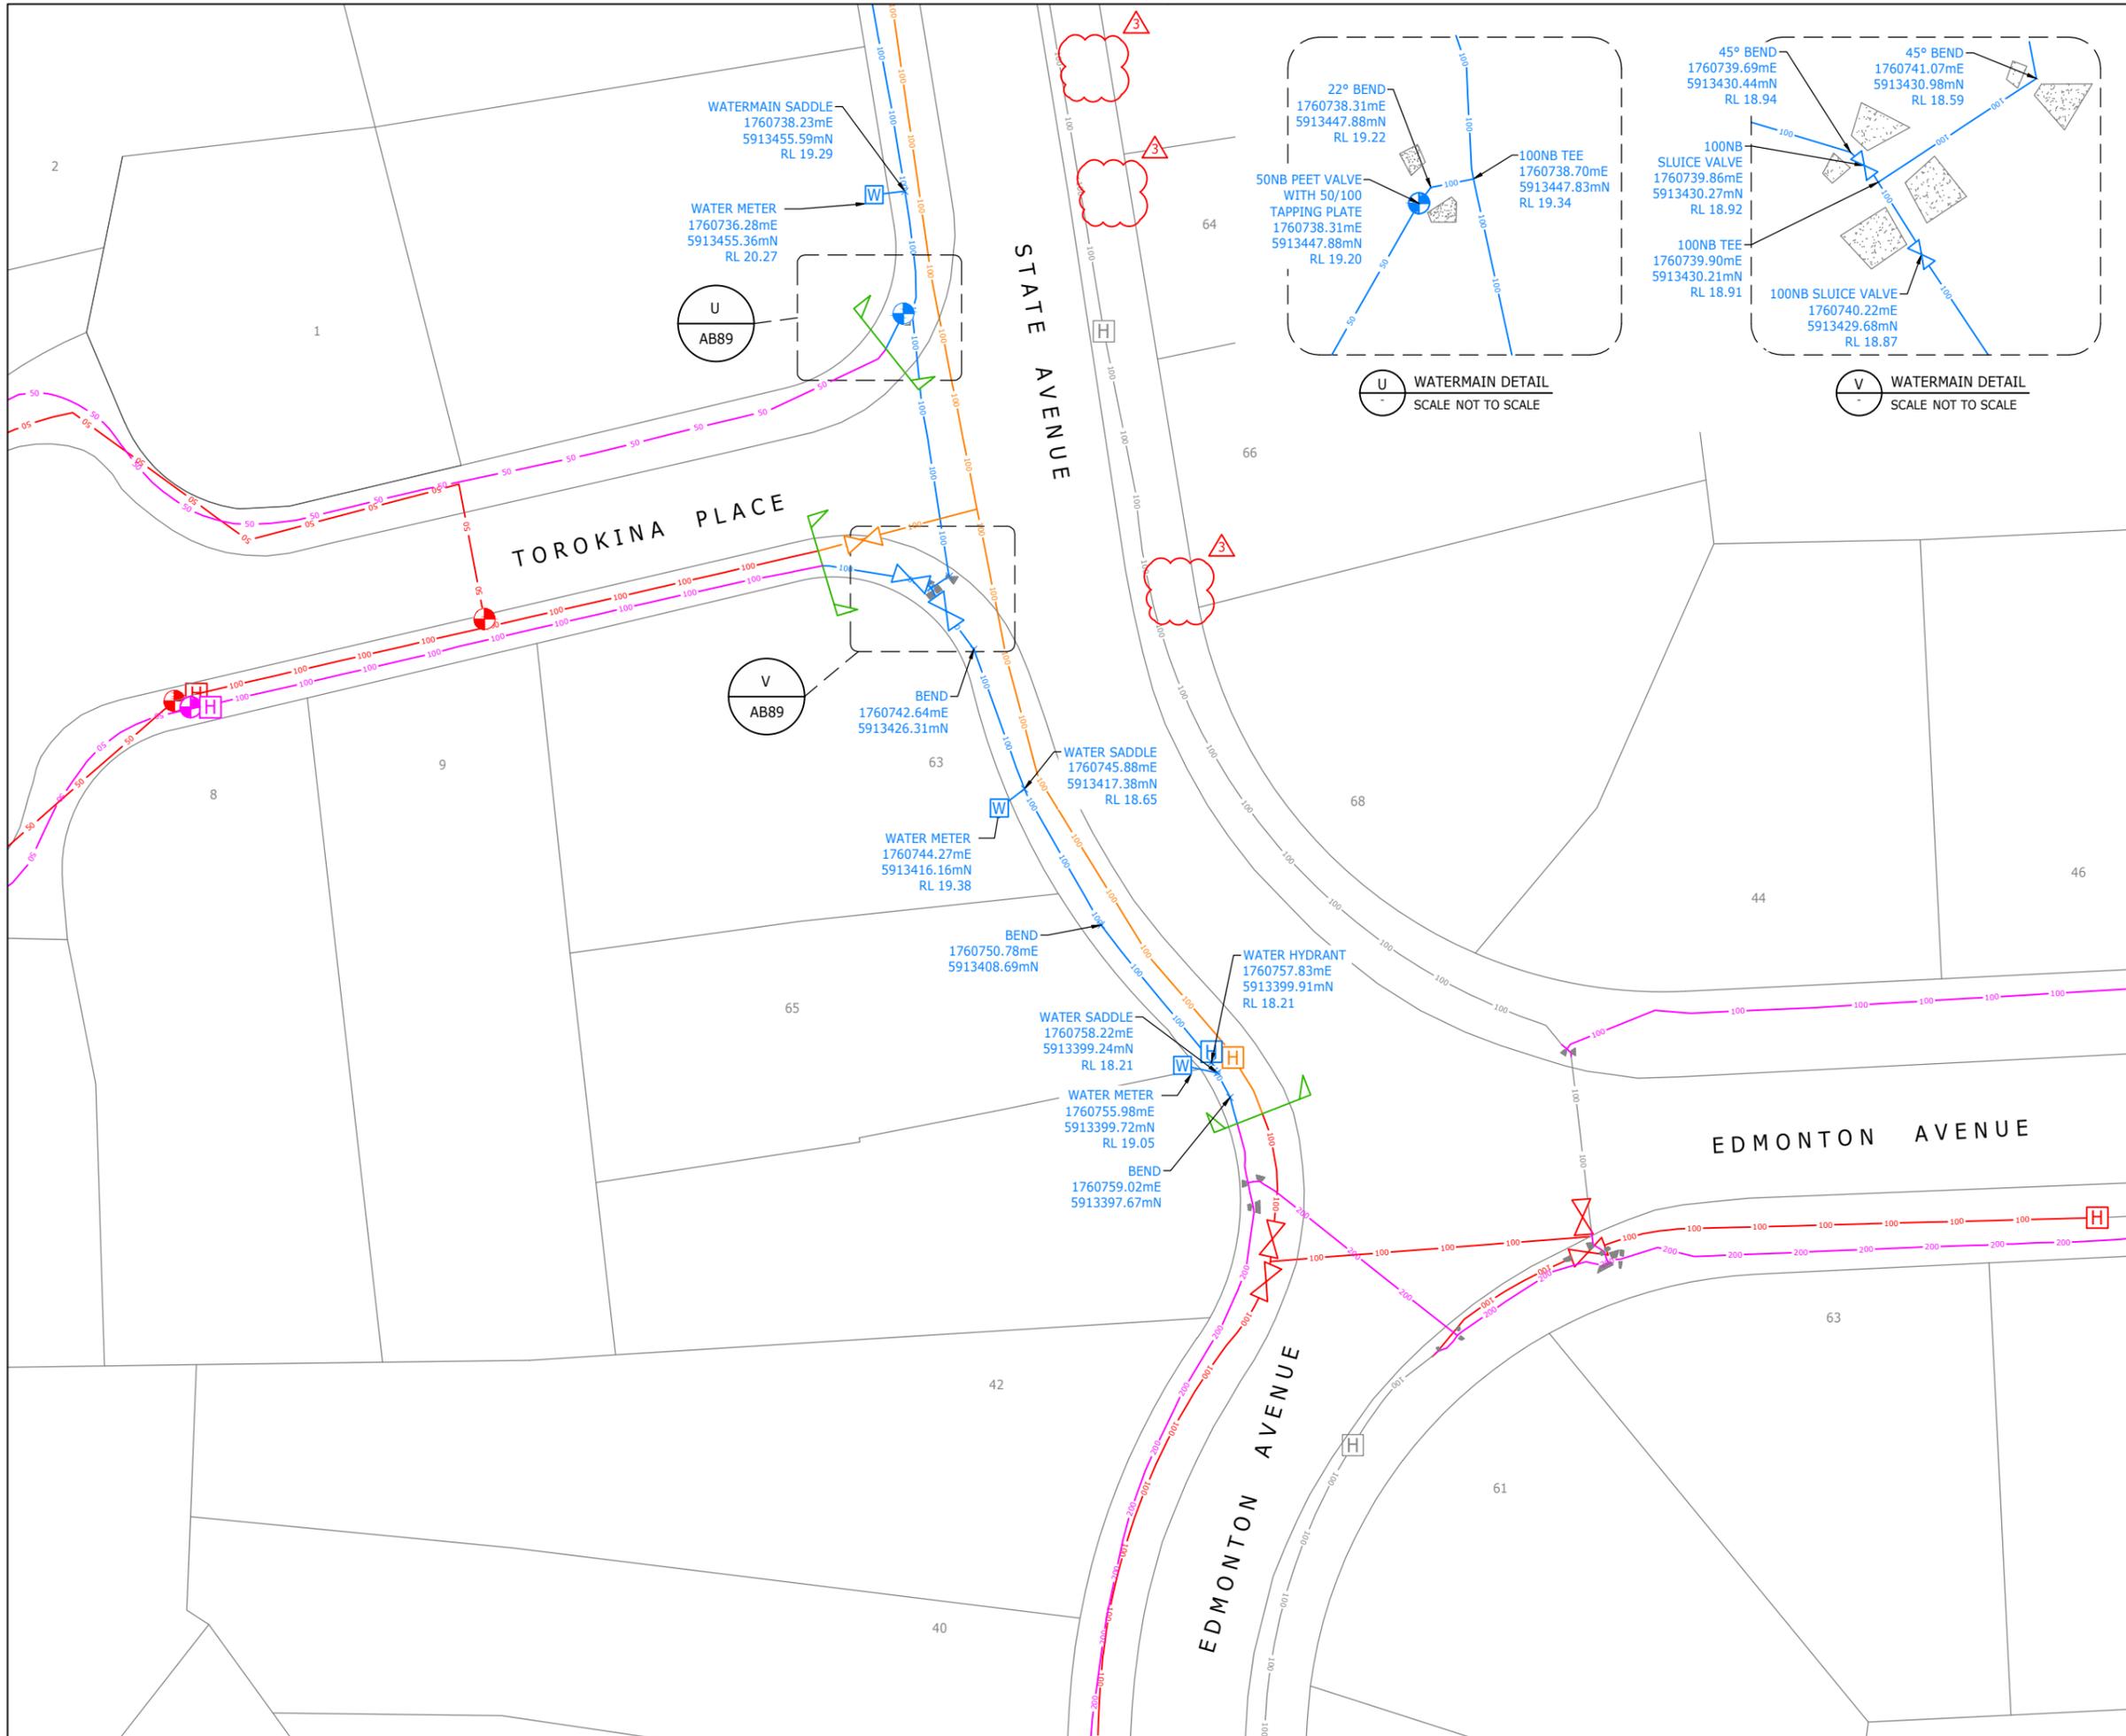

NOTE:
1. REFER TO D10041-AB82 FOR NOTES AND LEGEND

THIS PLAN HAS BEEN PREPARED IN ACCORDANCE WITH AUCKLAND COUNCIL ENGINEERING APPROVAL ENG60352314

EACC AS BUILT PLAN CERTIFICATION

I CERTIFY THAT THESE AS-BUILT PLANS ARE AN ACCURATE RECORD OF THE WORKS UNDERTAKEN AND THAT:

- THE COORDINATES (X, Y) ARE IN TERMS OF NZTM ON NZGD(2000), AND ARE WITHIN +/- 50mm.
- THE LEVELS (Z) ARE IN TERMS OF THE AUCKLAND 1946 (MSL) LINZ DATUM (DOSLI DATUM), AND ARE WITHIN THE FOLLOWING TOLERANCES:
 - FOR ALL PIPE INVERTS & ROADSIDE CHANNELS TO BE WITHIN +/- 10mm (LOCAL CIRCUIT IE. INTERNAL/RELATIVE CONSISTENCY REQUIRED ONLY).
 - FOR ALL OTHER ASSETS +/-20mm (MANHOLE COVERS, EARTHWORKS).

SIGNED: *Ryan Bruce Healey*
 LICENSED CADASTRAL SURVEYOR
 NAME: RYAN BRUCE HEALEY DATE: 04.04.2024



NO	REVISION DETAILS	BY	DATE
3	FOR COA APPROVAL	RBH	04.04.2024
2	FOR COA APPROVAL	RBH	13.03.2024
1	COA APPROVAL	RBH	30.11.2023

PROJECT: **ŌRANGA BERM AND UTILITIES UPGRADE**

DESCRIPTION: **STATE AVENUE WATERMAIN AS-BUILT PLAN SHEET 7**

STATUS	DESIGNED	DATE
SURVEYED	LEAD	11.2023
DESIGNED	-	-
DRAWN	CEA	11.2023
CHECKED	CA	04.04.2024
APPROVED	RBH	04.04.2024

SCALE	1:250 @A1	1:500 @A3	REVISION
STATUS	AS BUILT ISSUE		3
PRECINCT	ŌRANGA		
DWG NO	DIO041-AB89		

0 5 12.5 25 SCALE (m) 1:250 @A1 1:500 @A3

Synergy Version: Plot Date: 7:25:08 am, 6 April 2024, COLE AINU'U