

LEGEND:

- AS-BUILT STORMWATER PIPE
- EXISTING STORMWATER PIPE
- REMOVED STORMWATER
- STORMWATER ABANDONED IN-SITU AND GROUT FILLED
- AS-BUILT STORMWATER MANHOLE
- EXISTING STORMWATER SOAKHOLE
- EXISTING STORMWATER CATCHPIT
- REMOVED STORMWATER CATCHPIT

THIS PLAN HAS BEEN PREPARED IN ACCORDANCE WITH AUCKLAND COUNCIL ENGINEERING APPROVAL ENG60355957

EACC AS BUILT PLAN CERTIFICATION

I CERTIFY THAT THESE AS-BUILT PLANS ARE AN ACCURATE RECORD OF THE WORKS UNDERTAKEN AND THAT:

- THE COORDINATES (X, Y) ARE IN TERMS OF NZTM ON NZGD(2000), AND ARE WITHIN +/- 50mm.
- THE LEVELS (Z) ARE IN TERMS OF THE AUCKLAND 1946 (MSL) LINZ DATUM (DOSLI DATUM), AND ARE WITHIN THE FOLLOWING TOLERANCES:
 - FOR ALL PIPE INVERTS & ROADSIDE CHANNELS TO BE WITHIN +/- 10mm (LOCAL CIRCUIT IE. INTERNAL/RELATIVE CONSISTENCY REQUIRED ONLY).
 - FOR ALL OTHER ASSETS +/-20mm (MANHOLE COVERS, EARTHWORKS).

SIGNED
LICENSED CAD/JRNL SURVEYOR

NAME: RYAN BRUCE HEALEY DATE: 03.11.2023

2	FOR AS-BUILT	RBH	03.11.2023
1	FOR AS-BUILT	RBH	18.08.2023
REVISION DETAILS		BY	DATE

PROJECT:

ŌRANGA BERM WORKS

DESCRIPTION:


STORMWATER FILTER (ED-3)
AS-BUILT PLAN

SURVEYED	LEAD	08.2023
DESIGNED	-	-
DRAWN	CA	08.2023
CHECKED	EG	03.11.2023
APPROVED	RBH	03.11.2023


SCALE	1:50 @A1	1:100 @A3	REVISION	
STATUS	AS BUILT ISSUE		2	
PRECINCT	ŌRANGA			
DWG NO	DIO041-AB54			

Plot Date: 10:18:18 am, 1 November 2023, COLE AINUU


Synergy Version:

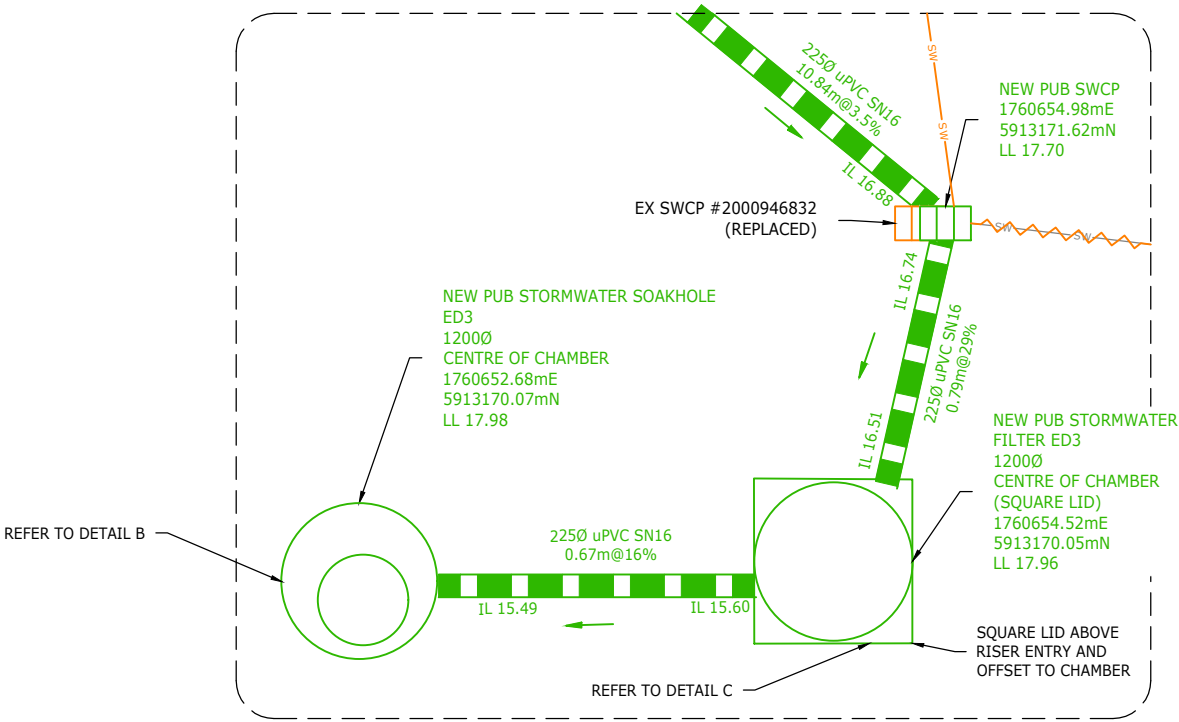


A NEW STORMWATER FILTER (ED-3) DETAIL
ABS2 NOT TO SCALE

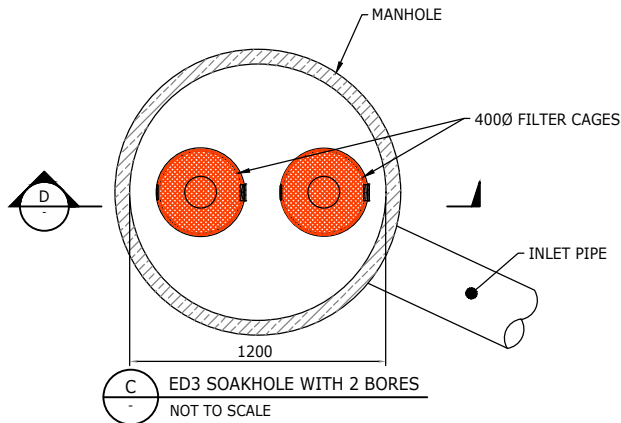

C ED3 SOAKHOLE WITH 2 BORES
NOT TO SCALE

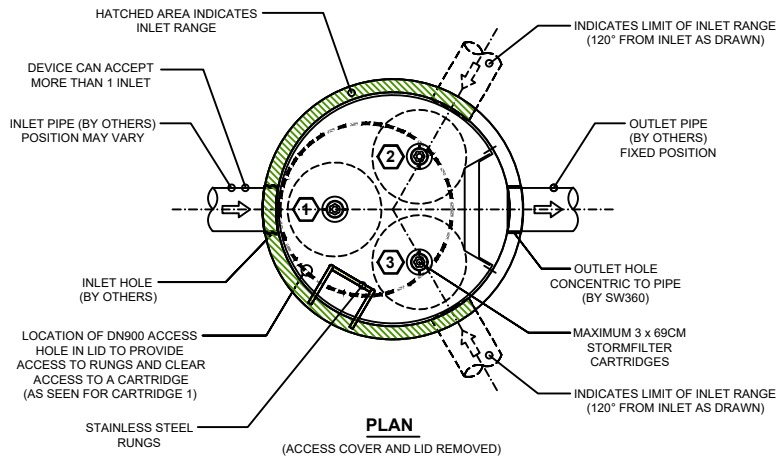


PLAN
(ACCESS COVER AND LID REMOVED)

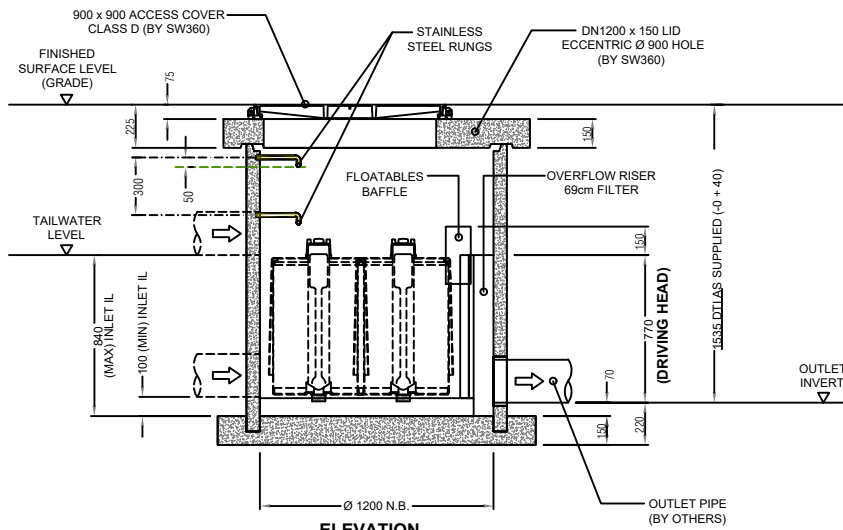

ELEVATION

C DIAGRAM
NOT TO SCALE

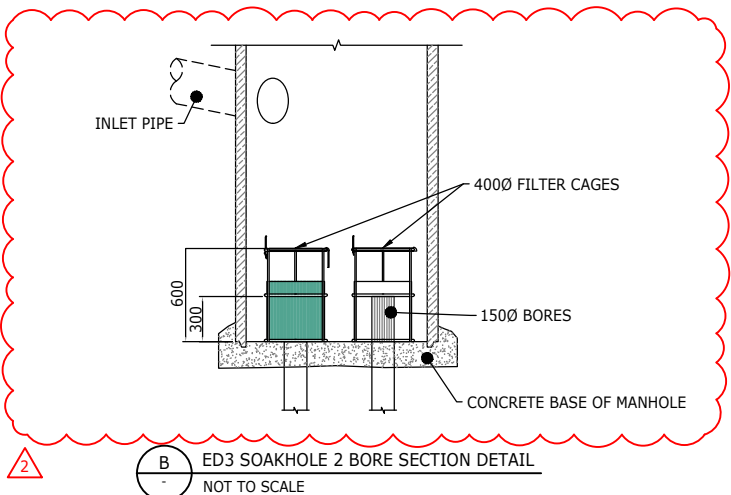

B ED3 SOAKHOLE 2 BORE SECTION DETAIL
NOT TO SCALE

- LEGEND:**
- AS-BUILT STORMWATER PIPE
 - EXISTING STORMWATER PIPE
 - REMOVED STORMWATER
 - STORMWATER ABANDONED IN-SITU AND GROUT FILLED
 - AS-BUILT STORMWATER MANHOLE
 - EXISTING STORMWATER SOAKHOLE
 - EXISTING STORMWATER CATCHPIT
 - REMOVED STORMWATER CATCHPIT

THIS PLAN HAS BEEN PREPARED IN ACCORDANCE WITH AUCKLAND COUNCIL ENGINEERING APPROVAL ENG60355957

EACC AS BUILT PLAN CERTIFICATION

I CERTIFY THAT THESE AS-BUILT PLANS ARE AN ACCURATE RECORD OF THE WORKS UNDERTAKEN AND THAT:

- THE COORDINATES (X, Y) ARE IN TERMS OF NZTM ON NZGD(2000), AND ARE WITHIN +/- 50mm.
- THE LEVELS (Z) ARE IN TERMS OF THE AUCKLAND 1946 (MSL) LINZ DATUM (DOSLI DATUM), AND ARE WITHIN THE FOLLOWING TOLERANCES:
 - FOR ALL PIPE INVERTS & ROADSIDE CHANNELS TO BE WITHIN +/- 10mm (LOCAL CIRCUIT IE. INTERNAL/RELATIVE CONSISTENCY REQUIRED ONLY).
 - FOR ALL OTHER ASSETS +/-20mm (MANHOLE COVERS, EARTHWORKS).


SIGNED
LICENSED CAD/DRAWING SURVEYOR
NAME: RYAN BRUCE HEALEY DATE: 03.11.2023



2	FOR AS-BUILT	RBH	03.11.2023
1	FOR AS-BUILT	RBH	18.08.2023
REVISION DETAILS		BY	DATE

PROJECT: **ŌRANGA BERM WORKS**

DESCRIPTION: **STORMWATER FILTER (ED-3) AS-BUILT DETAILS**

	SURVEYED	PIRITAHĪ	08.2023
	DESIGNED	-	-
	DRAWN	CA	08.2023
	CHECKED	EG	03.11.2023
	APPROVED	RBH	03.11.2023
SCALE	AS SHOWN		REVISION
STATUS	AS BUILT ISSUE		2
PRECINCT	ŌRANGA		
DWG NO	DIO041-AB55		