

LEGEND:

- AS-BUILT STORMWATER PIPE
- EXISTING STORMWATER PIPE
- STORMWATER PIPE REMOVE
- AS-BUILT STORMWATER MANHOLE
- EXISTING STORMWATER SOAKHOLE
- AS-BUILT STORMWATER CATCHPIT
- EXISTING STORMWATER CATCHPIT
- REMOVED STORMWATER CATCHPIT

THIS PLAN HAS BEEN PREPARED IN ACCORDANCE WITH AUCKLAND COUNCIL ENGINEERING APPROVAL ENG60355982

 


AS BUILT PLAN CERTIFICATION

I CERTIFY THAT THESE ASBUILT PLANS ARE AN ACCURATE RECORD OF THE WORKS UNDERTAKEN AND THAT:

- THE COORDINATES (X,Y) ARE IN TERMS OF NZTM ON NZGD (2000), AND ARE WITHIN ±50mm.
- THE LEVELS (Z) ARE IN TERMS OF THE AUCKLAND 1946 (MSL) LINZ DATUM (DOSLI DATUM), AND ARE WITHIN ±10mm.

SIGNED: *Ryan Bruce Healey*

LICENSED CATHOLIC SURVEYOR
MSSNZ
DATE: 08.06.2023
NAME: RYAN BRUCE HEALEY

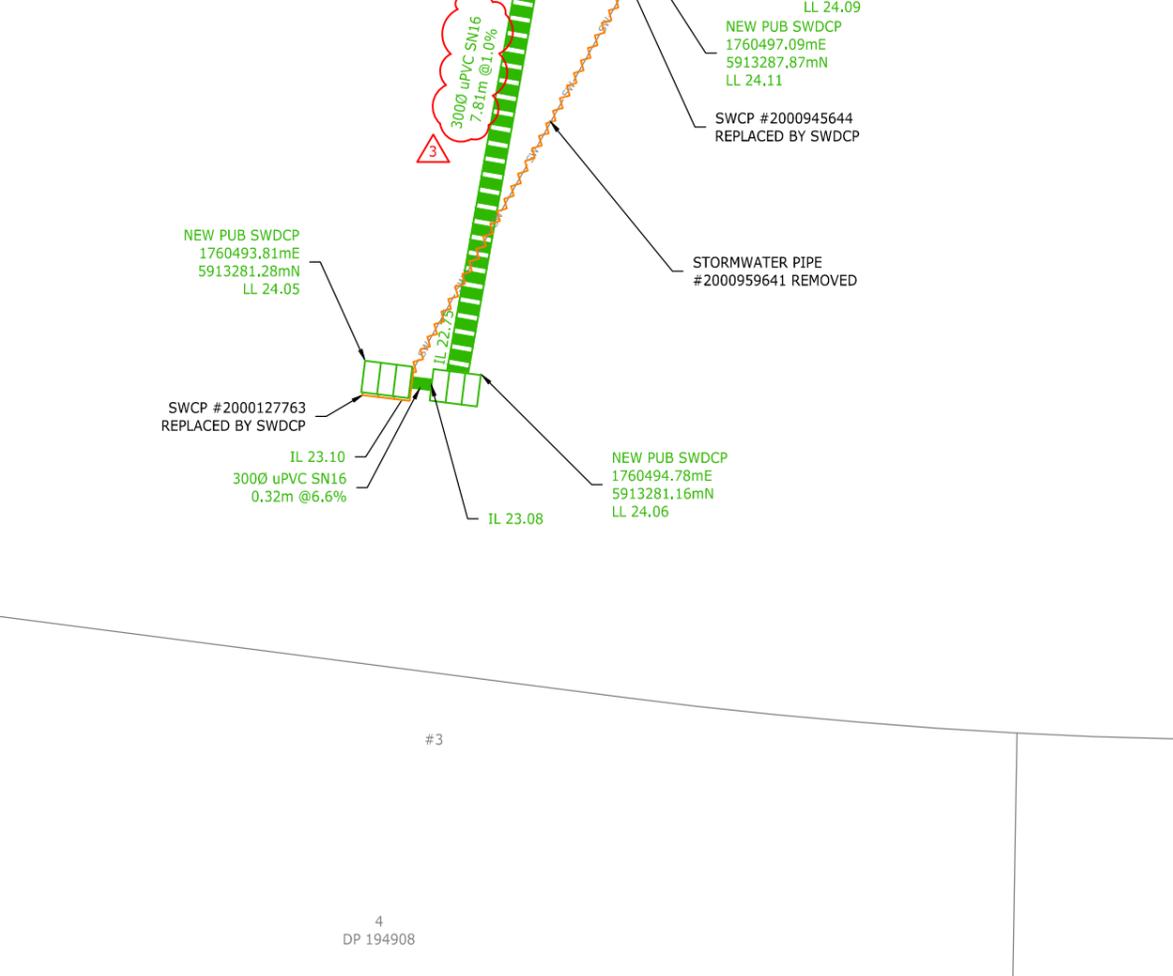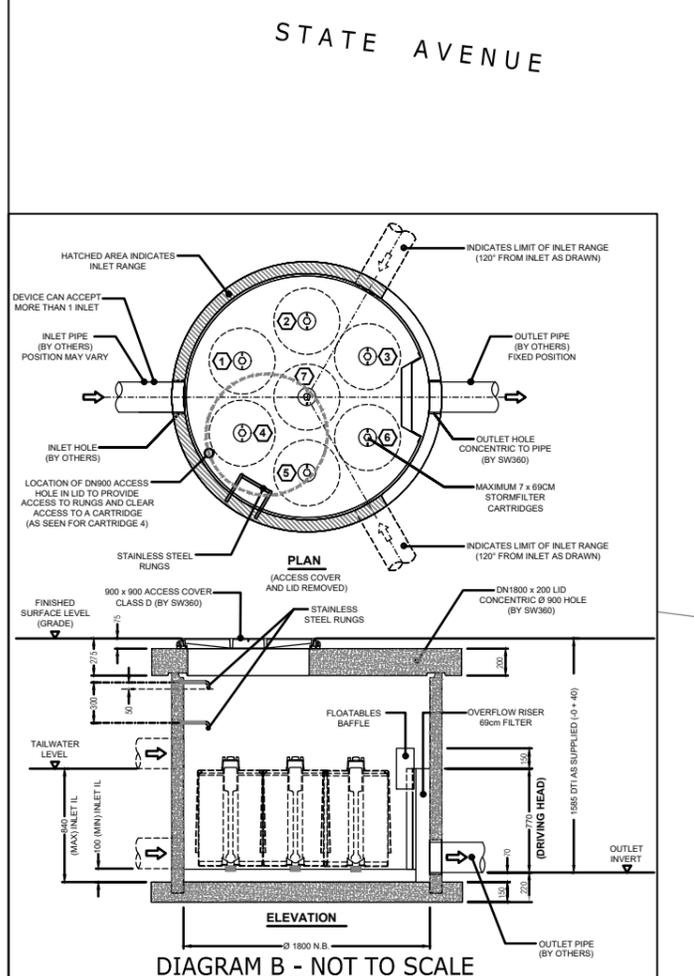

REVISION	BY	DATE
3	RBH	08.06.2023
2	RBH	20.02.2023
1	RBH	16.12.2022

PROJECT: **ŌRANGA BERM WORKS**

DESCRIPTION: **STORMWATER FILTER (ST-1) AS-BUILT PLAN**

SURVEYED	PIRITAHİ	07.2022
DESIGNED	-	-
DRAWN	CA	07.2022
CHECKED	SH	08.06.2023
APPROVED	RBH	08.06.2023

SCALE: 1:50 @A1 | 1:100 @A3

STATUS: EACC APPROVAL

PRECINCT: ŌRANGA

DWG NO: **DIO041-AB23**

REVISION: **3**